

KANSAS CORPORATION COMMISSION OIL & GAS CONSERVATION DIVISION

Form CP-1 September 2003 This Form must be Typed Form must be Signed All blanks must be Filled


WELL PLUGGING APPLICATION

Please TYPE Form and File ONE Copy

API # 15 - 155-21222 - 000	(Identifier Number of this we	ell). This must be listed for wells d	rilled since 1967; if no API # was issued,	
indicate original spud or completion date 10/21/9	92			
Well Operator: FALCON EXPLORATION INC.		KCC License #: 5316		
Address: 125 N. MARKET, SUITE 1252		City:_WICHITA	(Operator's)	
	Zip Code: 67202) 262 - 1378	
	Well #: 1			
C C\M C\M		unty: RENO		
Feet (in exact footage) From	North / V South (from ne	earest outside section corner) Line o	of Section (Not Lease Line)	
Feet (in exact footage) From		earest outside section comer) Line o		
Check One: Oil Well Gas Well	D&A Cathodic	Water Supply Well		
SWD Docket #	ENHR Docket #		Other:	
Conductor Casing Size:	Set at:	Cemented with:	Sacks	
Surface Casing Size: 8-5/8"	Set at: <u>369</u>	Cemented with: 2	Sacks	
Production Casing Size: 5-1/2	Set at: 3775	Cemented with: 1	30 Sacks	
Elevation: 1672 (G.L./VK.B.) T.D.: 380		Anhydrite Depth:	(Stone Corral Formation) KANCAS CODDODATION COMMISSION	
Proposed Method of Plugging (attach a separate pag		R KCC INSTRUCTIONS	KANSAS CORPORATION COMMISSION	
			APR 1 6 2009	
			RECEIVED	
Is Well Log attached to this application as required?	Yes No Is ACO-1 fi	led? Yes No	·	
Plugging of this Well will be done in accordance List Name of Company Representative authorized to		I CON KUUN		
Address: P O BOX 551		City / State: RUSSELL		
Plugging Contractor: H-D OILFIELD SERVICE INC.			KCC License #: 32970	
Address: POBOX 87, BAZINE KS 67516	ompany Name)	Phone: (785) 398	(Contractor's) 3 - 2289	
Proposed Date and Hour of Plugging (if known?): _		1 Hone,		
Payment of the Plugging Fee (K.A.R. 82-3-118) w		Agent		
Date: 4/16/09 Authorized Operator	/ Agent:		·	
·	-	(Signature)	2	

Mail to: KCC - Conservation Division, 130 S. Market - Room 2078, Wichita, Kansas 67202

STORY STORY

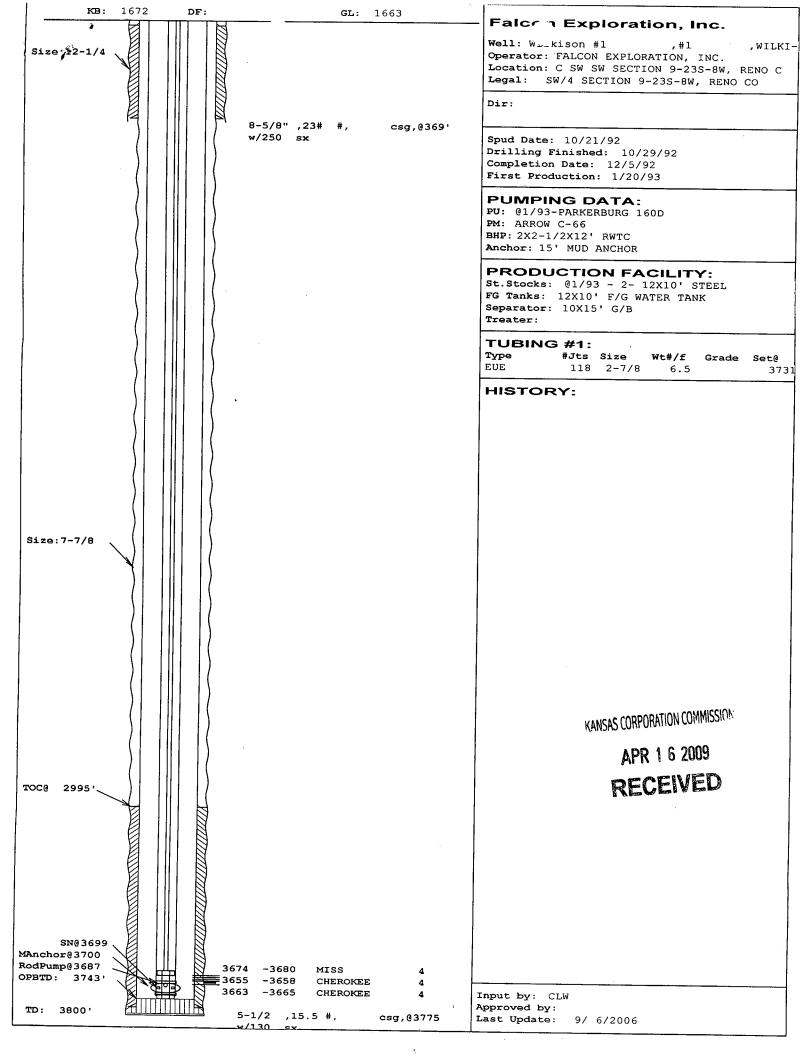



Kathleen Sebelius, Governor Thomas E. Wright, Chairman Michael C. Moffet, Commissioner Joseph F. Harkins, Commissioner

NOTICE OF RECEIPT OF WELL PLUGGING APPLICATION (CP-1)

FALCON EXPLORATION, INC. 125 N MARKET STE 1252 WICHITA, KS 67202-1719 April 20, 2009

Re: WILKINSON #1

API 15-155-21222-00-00

9-23S-8W, 660 FSL 4620 FEL RENO COUNTY, KANSAS

Dear Operator:

This letter is to notify you that the Conservation Division has received your plugging proposal, form CP-1, for the above well and has reviewed the proposal for completeness. The central office will now forward your CP-1 to the district office listed below for review of the proposed plugging method. Please contact the district office for approval of your proposed plugging method at least five (5) days before plugging the well, pursuant to K.A.R. 82-3-113(b). If a workover pit will be used during the plugging of the well it must be permitted. A CDP-1 form must be filed and approved prior to the use of the pit in accordance with K.A.R. 82-3-600.

The Conservation Division's review of form CP-1, either in the central or district office, does not include an inquiry into well ownership or the filing operator's legal right to plug the well. This notice in no way constitutes authorization to plug the above well by persons not having legal rights of ownership or interest in the well.

This notice is void after October 17, 2009. The CP-1 filing does not bring the above well into compliance with K.A.R. 82-3-111 with regard to the Commission's temporary abandonment requirements.

Sincerely,

Steve Bond

Production Department Supervisor

District: #2

3450 N. Rock Road, Suite 601

Wichita, KS 67226 (316) 630-4000