


15-195-20329-00-00

FORM CP-4

STATE OF KANSAS  
STATE CORPORATION COMMISSION  
CONSERVATION DIVISION  
P. O. BOX 17027  
WICHITA, KANSAS 67217

WELL PLUGGING RECORD

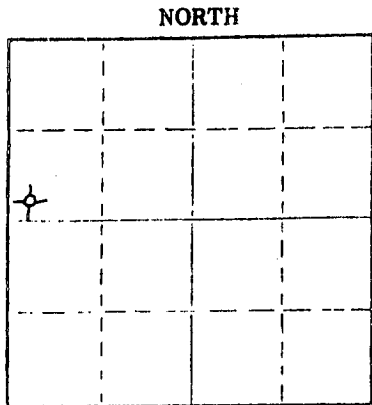

Locate well correctly on above Section Plat

Trego County. Sec 30 Twp 11S Rge. 24 (E) (W)  
Location as "NE/CNW/SW" or footage from lines. SW SW NW  
Lease Owner Mack Oil Co.  
Lease Name McIntosh Well No. 1  
Office Address 812 Union Center Bldg., Wichita, KS 67202  
Character of Well (completed as Oil, Gas or Dry Hole) Dry hole  
Date well completed 5-9-75 19  
Application for plugging filed 5-8-75 19  
Application for plugging approved 5-8-75 19  
Plugging commenced 5-8-75 19  
Plugging completed 5-9-75 19  
Reason for abandonment of well or producing formation commercial quantities of oil not found  
If a producing well is abandoned, date of last production 19  
Was permission obtained from the Conservation Division or its agents before plugging was commenced? yes

Name of Conservation Agent who supervised plugging of this well Gilbert Balthouser  
Producing formation \_\_\_\_\_ Depth to top \_\_\_\_\_ Bottom \_\_\_\_\_ Total Depth of Well 4175 Feet  
Show depth and thickness of all water, oil and gas formations.

OIL, GAS OR WATER RECORDS

CASING RECORD

FORMATION	CONTENT	FROM	TO	SIZE	PUT IN	PULLED OUT
				8-5/8"	202'	

Describe in detail the manner in which the well was plugged, indicating where the mud fluid was placed and the method or methods used in introducing it into the hole. If cement or other plugs were used, state the character of same and depth placed, from \_\_\_\_\_ feet to \_\_\_\_\_ feet for each plug set.

1100' w/70 sx  
200' w/20 sx  
40' w/bridge & 10 sx

RECEIVED  
STATE CORPORATION COMMISSION  
MAY 14 1975  
CONSERVATION DIVISION  
Wichita, Kansas

(If additional description is necessary, use BACK of this sheet)

Name of Plugging Contractor Rains & Williamson Oil Co., Inc.  
Address 435 Page Court, 220 W. Douglas, Wichita, KS 67202

STATE OF Kansas COUNTY OF Sedgwick ss.  
Wilson Rains, President (employee of owner) or (owner or operator) of the above-described well, being first duly sworn on oath, says: That I have knowledge of the facts, statements, and matters herein contained and the log of the above-described well as filed and that the same are true and correct. So help me God.

(Signature) Wilson Rains  
435 Page Court, 220 W. Douglas, Wichita, KS  
(Address)

12th day of May 1975 67202

October 4, 1975

Juanita M. Green  
Notary Public.



15-95-20329-00-00  
**WELL LOG**

COMPANY Mack Oil Co.

SEC. 30 T. 11S R. 24W  
 LOC. SW SW NW

FARM McIntosh NO. 1


RIG. NO. 7

TOTAL DEPTH 4175'

COMM. 4-30-75

COMP. 5-9-75

COUNTY Trego  
 KANSAS

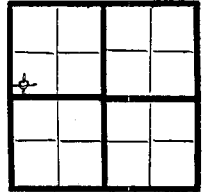

CONTRACTOR Rains & Williamson Oil Co., Inc.

**CASINO**

20	10	
15	8	-5/8" @ 202' w/150 sx common, 2% ge
12	6	3% cc
13	5	

PRODUCTION D&A

FIGURES INDICATE BOTTOM OF FORMATIONS

Shale	245
Shale & Sand	1900
Shale	2128
Anhydrite	2173
Shale	2590
Shale & Lime	3190
Lime & Shale	3765
Lime	4175
<u>Rotary Total Depth</u>	<u>4175</u>

RECEIVED  
 STATE CORPORATION COMMISSION  
 5-14-1975  
 CONSERVATION DIVISION  
 Topeka, Kansas

State of Kansas }  
 County of Sedgwick } ss:

I, Wilson Rains, President of the Rains & Williamson Oil Company, Inc.

upon oath state that the above and foregoing is a true and correct copy of the log of the McIntosh #1 well.

Wilson Rains  
 Wilson Rains

Subscribed and sworn to before me this 12th day of May 19 75

Juanita M. Green  
 NOTARY PUBLIC  
 Juanita M. Green

My Commission Expires: October 4, 1975

