

STATE OF KANSAS
STATE CORPORATION COMMISSION
200 Colorado Derby Bldg.
Wichita, Kansas 67202

WELL PLUGGING RECORD

Give All Information Completely
Make Required Affidavit

COUNTY Trego SEC. 33 TWP. 11S RGE. 24 ~~SE~~/W
Location as in quarters or footage from lines:
150' NE C NW NE

Locate Well
correctly on above
Section Platt.

Lease Owner Oxford Exploration Co.
Lease Name Malinowsky Well No. 33-2
Office Address 1550 Denver Club Bldg., Denver, CO 80202
Character of Well (Completed as Oil, Gas or Dry Hole): Dry Hole
Date Well Completed 8-25-82
Application for plugging filed 8-25-82
Plugging commenced 8-25-82
Plugging completed 8-25-82
Reason for abandonment of well or producing formation _____

Dry hole
Was permission obtained from the Conservation Division or it's
Agent's before plugging was commenced? yes

Name of Conservation Agent who supervised plugging of this well Marion Schmidt
Producing formation _____ Depth to top _____ bottom _____ T.D. 4160'
Show depth and thickness of all water, oil and gas formations.

OIL, GAS OR WATER RECORDS Casing Record

Formation	Content	From	To	Size	Put in	Pulled Out
Surface				8-5/8"	219'	none


Describe in detail the manner in which the well was plugged, indicating where the mud
fluid was placed and the method or methods used in introducing it into the hold. If cement
or other plugs were used, state the character of same and depth placed, from _____ feet
to _____ feet for each plug set.

RECEIVED
STATE CORPORATION COMMISSION
9-9-1982
SFP 09 1982
CONSERVATION DIVISION
Wichita, Kansas

1st plug set @ 840' w/100 sx.
2nd plug set @ 270' w/40 sx.
3rd plug set @ 40' w/10 sx.
10 sx in the rathole

(If additional description is necessary, use BACK of this sheet)
Name of Plugging Contractor Murfin Drilling Company

STATE OF KANSAS COUNTY OF SEDCWICK, ss.
David L. Murfin (employee of owner) or (owner or operator) of the
above-described well, being first duly sworn on oath, says: That I have knowledge of the
facts, statements, and matters herein contained and the log of the above-described well as
filed and that the same are true and correct. So help me God.

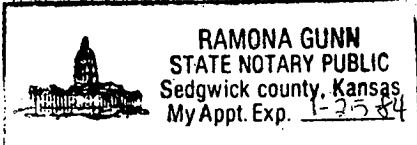

(Signature) David L. Murfin
David L. Murfin - 617 Union Ctr. Bl.
Wichita, KS (Address) 67202

SUBSCRIBED AND SWORN TO before me this 31st day of August, 19 82

Ramona Gunn
Notary Public.
Ramona Gunn

My Commission expires: 1-25-84

15-195-21070-00-00
WELL LOG

COMPANY Oxford Exploration Co., Inc.

SEC. 33 T. 11S^R. 24W
 LOC. 150' NE C NW NE

FARM Malinowsky NO. 33-2


RIG. NO. 15

TOTAL DEPTH 4160'

COUNTY Trego
 KANSAS

COMM. 8-19-82

COMP. 8-25-82

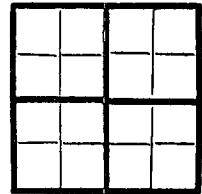

CONTRACTOR Murfin Drilling Company

CASING		
20	10	
15	8 -5/8" csg set @ 219' w/180' sx Common Quickset	ELEVATION
12	6	
13	5	PRODUCTION

FIGURES INDICATE BOTTOM OF FORMATIONS

Surface Clay & Shale	218'
Shale & Sand	1640'
Sand (Dakota)	1865'
Shale (Red Bed)	2107'
Anhydrite	2148'
Shale	2555'
Shale & Lime	4095'
Lime	4160'

RECEIVED
 STATE CORPORATION COMMISSION
 9-9-1982
 SFP 09 1982
 CONSERVATION DIVISION
 Wichita, Kansas

State of KANSAS)
 County of SEDGWICK) ss:

I, David L. Murfin of the Murfin Drilling Company

upon oath state that the above and foregoing is a true and correct copy of the log of the Malinowsky #33-2 well.



RAMONA GUNN
 STATE NOTARY PUBLIC
 Sedgwick county, Kansas
 My Appt. Exp. 1-25-84

David L. Murfin
 David L. Murfin

Subscribed and sworn to before me this 31st day of August 19 82.

My Commission Expires: 1-25-84

Ramona Gunn
 Ramona Gunn NOTARY PUBLIC