


STATE OF KANSAS
STATE CORPORATION COMMISSION

Give All Information Completely
Make Required Affidavit
Mail or Deliver Report to
Conservation Division
State Corporation Commission
245 North Water
Wichita, KS 67202

FORM CP-4

WELL PLUGGING RECORD

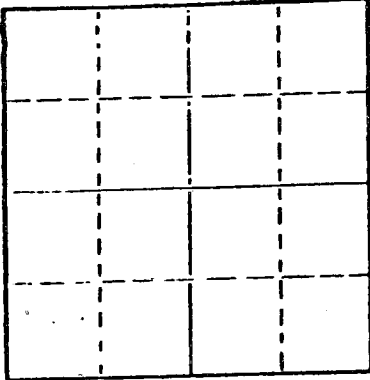

Locate well correctly on above
Section Plat

Sheridan County. Sec. 6 Twp. 9 Rge. 28 (E) (W)
Location as "NE/CNW/SE/SW" or footage from lines NE-NW-NE
Lease Owner Patton Oil Company
Lease Name Clark #3 Well No.
Office Address Hoisington, Kansas
Character of Well (completed as Oil, Gas or Dry Hole)
Date well completed 19
Application for plugging filed 19
Application for plugging approved 19
Plugging commenced 4/5/76 19
Plugging completed 4/15/76 19
Reason for abandonment of well or producing formation depleted.
If a producing well is abandoned, date of last production 19
Was permission obtained from the Conservation Division or its agents before plugging was commenced? yes

Name of Conservation Agent who supervised plugging of this well Balthazor
Producing formation Depth to top Bottom Total Depth of Well 3991 Feet
Show depth and thickness of all water, oil and gas formations.

OIL, GAS OR WATER RECORDS

CASING RECORD

FORMATION	CONTENT	FROM	TO	SIZE	PUT IN	PULLED OUT
				8-5/8	182	none
				5 1/2"	3977	1528'

Describe in detail the manner in which the well was plugged, indicating where the mud fluid was placed and the method or methods used in introducing it into the hole. If cement or other plugs were used, state the character of same and depth placed, from feet to feet for each plug set.

Sanded hole to 3850' and dumped 5 sacks cement. Shot pipe at 2300', 2118', 2021', 1929', 1837', 1740', pipe parted at 120'. Pulled 4 joints. Had to fish pipe. Shot pipe at 1519', pulled 48 joints. Plugged well with 3 sacks hulls, 130 sacks cement, 50-50 pos, 6% gel and 17 sacks gel.

PLUGGING COMPLETE

(If additional description is necessary, use BACK of this sheet)
Name of Plugging Contractor KELSO CASING PULLING
Address Chase, Kansas

STATE OF Kansas COUNTY OF Rice ss.
R. Darrell Kelso (employee of owner) or (owner or operator) of the above-described well, being first duly sworn on oath, says: That I have knowledge of the facts, statements, and matters herein contained and the log of the above-described well as filed and that the same are true and correct. So help me God.

(Signature) R. Darrell Kelso
Chase, Kansas (Address)

SUBSCRIBED AND SWORN TO before me this 19th day of April 1976

My commission expires
NOTARY PUBLIC MARGARET MELCHER
Rice County, Ks.
My Comm. Exp. Feb. 15, 1979

Margaret Melcher
Notary Public

RECEIVED BY
STATE CORPORATION COMMISSION
4-21-76
APR 21 1976
CONSERVATION DIVISION
Wichita, Kansas

15-179-30100-0000
6-7-66
7E NW 1/4

WELL LOG

COMPANY Murfin-Patton

SEC. 6 T. 9S R. 28W
LOC. NE NW NE

FARM Clark NO. three

RIG. NO. 16

TOTAL DEPTH 3991

COMM. 11-28-66


COMP. 12-7-66

SHOT OR TREATED

CONTRACTOR Murfin Drilling Company

ISSUED

COUNTRY Sheridan - Kansas
KANSAS

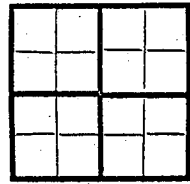

CASING

20	10	
15	8	5/8" w/140 sacks
12	6	
13	5	1/2" w/100 sacks

ELEVATION 2725 KB

PRODUCTION 40 BOPD PLUS
4000 GPD

FIGURES INDICATE BOTTOM OF FORMATIONS

150	Sand
1310	Shale
1876	Shale & Sand
2332	Shale
2368	Anhydrite
2462	Shale - Shells
3220	Shale - Lime
3385	Lime - Shale
3470	Lime
3675	Lime - Shale
3775	Lime
3825	Lime - Shale
3970	Lime
3991	RTD

TOPS: SCOUT

Topeka	3447
Heebner	3792
Toronto	3814
Lansing Kansas City	3829

RECORDED
MAR 3 1966
NOTARY PUBLIC

State of KANSAS
 State of KANSAS
 County of SEDGWICK } ss:

I, W. R. Murfin of the Murfin Drilling Company

upon oath state that the above and foregoing is a true and correct copy of the log of the Clark #3 well.

W. R. Murfin
W. R. Murfin

Subscribed and sworn to before me this 14th day of December 19 66

My Commission Expires: ADELA MIZNER, Notary Public
My Commission expires November 5, 1970

Adela Mizner
NOTARY PUBLIC