

STATE OF KANSAS
STATE CORPORATION COMMISSION


Give All Information Completely
Make Required Affidavit
Mail or Deliver Report to:
Conservation Division
State Corporation Commission
211 No. Broadway
Wichita, Kansas

WELL PLUGGING RECORD

SHERIDAN County. Sec. 23 Twp. 9 Rge. 26 (E) W (W)

Location as "NE/CNW/SW" or footage from lines SW SW SE
Lease Owner THEODORE GORE
Lease Name EPLER Well No. 1
Office Address 400 BROWN BUILDING, WICHITA 2, KANSAS
Character of Well (completed as Oil, Gas or Dry Hole) DRY HOLE
Date well completed MARCH 8 19 56
Application for plugging filed MARCH 8 19 56
Application for plugging approved MARCH 8 19 56
Plugging commenced MARCH 8 19 56
Plugging completed MARCH 8 19 56
Reason for abandonment of well or producing formation DRY HOLE

NORTH

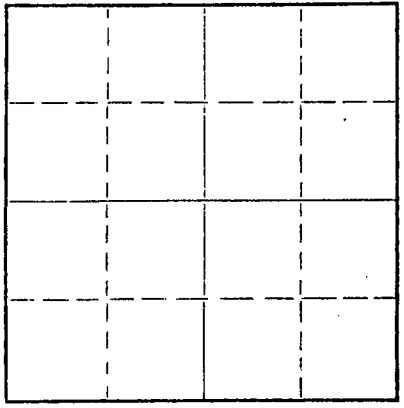

Locate well correctly on above Section Plat

If a producing well is abandoned, date of last production 19
Was permission obtained from the Conservation Division or its agents before plugging was commenced? YES

Name of Conservation Agent who supervised plugging of this well ELDON PETTY
Producing formation Depth to top Bottom Total Depth of Well 4490 Feet
Show depth and thickness of all water, oil and gas formations.

OIL, GAS OR WATER RECORDS

CASING RECORD

FORMATION	CONTENT	FROM	TO	SIZE	PUT IN	PULLED OUT
SURFACE		0	196'	8 5/8"	176'	0

Describe in detail the manner in which the well was plugged, indicating where the mud fluid was placed and the method or methods used in introducing it into the hole. If cement or other plugs were used, state the character of same and depth placed, from feet to feet for each plug set.

BOTTOM PLUG SET AT 170' WITH ONE-HALF SACK HULLS AND 15 SACKS OF CEMENT.
TOP PLUG SET AT 40' WITH ONE-HALF SACK HULLS AND 10 SACKS OF CEMENT.

(If additional description is necessary, use BACK of this sheet)


Name of Plugging Contractor EMPIRE DRILLING COMPANY
Address 400 BROWN BUILDING, WICHITA 2, KANSAS

STATE OF KANSAS, COUNTY OF SEDGWICK, ss.
I, DAN J. KORNFELD (employee of owner) of the above-described well, being first duly sworn on oath, says: That I have knowledge of the facts, statements, and matters herein contained and the log of the above-described well as filed and that the same are true and correct. So help me God.

(Signature) DAN J. KORNFELD
400 BROWN BUILDING, WICHITA 2, KANSAS
(Address)

SUBSCRIBED AND SWORN to before me this 16TH day of MARCH, 1956
My commission expires JUNE 7, 1956

Charlotte Kletchka
CHARLOTTE KLETCHKA Notary Public.

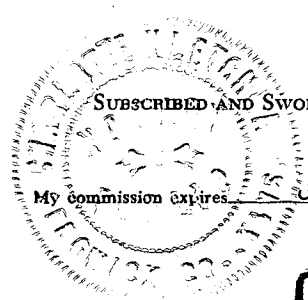

PLUGGING
FILE SEC 23 T 9 R 26 W
BOOK PAGE 44 LINE 38

3-22-56

L O G

COMPANY: THEODORE GORE
 CONTRACTOR: EMPIRE DRILLING COMPANY
 FARM: EPLER NO. 1
 LOCATION: SW SW SE, SEC. 23-9-26
 SHERIDAN COUNTY, KANSAS
 COMMENCED: 2-24-56
 COMPLETED: 3-8-56

0	TO	196	SURFACE SHALE AND SAND
196	TO	1380	SHALE AND SAND
1380	TO	1610	SHALE, SHELLS AND SAND
1610	TO	2281	SHALE AND SAND
2281	TO	2320	ANHYDRITE
2320	TO	2700	SHALE AND SHELLS
2700	TO	3810	LIME AND SHALE
3810	TO	4098	LIME
4098	TO	4210	SHALE AND LIME
4210	TO	4254	LIME
4254	TO	4295	SHALE AND LIME
4295	TO	4323	SHALE
4323	TO	4398	SHALE AND LIME
4398	TO	4437	SHALE
4437	TO	4490	LIME AND CHERT
4490			R.T.D.

SET B 5/8" SURFACE CASING AT 176', CEMENTED WITH 115 SACKS OF CEMENT.

ELEVATION: 2634 K.B.

TOPS: ANHYDRITE 2281'; MEEBNER 3844'; TORONTO 3866'; LANSING 3884'; BASE KANSAS CITY 4100'; CONGLOMERATE 4420'; MISSISSIPPIAN 4440'; R.T.D. 4490'.

NO DRILL STEM TESTS TAKEN.

D & A

C E R T I F I C A T I O N

I, DAN J. KORNFELO, DO HEREBY CERTIFY THAT THE ABOVE AND FOREGOING IS A TRUE AND CORRECT COPY OF THE LOG ON THE EPLER NO. 1, SW SW SE, SECTION 23, TOWNSHIP 9 SOUTH, RANGE 26 WEST, SHERIDAN COUNTY, KANSAS, AS REFLECTED BY THE FILES OF THE EMPIRE DRILLING COMPANY.

Dan J. Kornfeld
 DAN J. KORNFELO

SUBSCRIBED AND SWORN TO BEFORE ME A NOTARY PUBLIC WITHIN AND FOR SEDGWICK COUNTY, KANSAS, THIS 16TH DAY OF MARCH, 1956.

MY COMMISSION EXPIRES: JUNE 7, 1956.

Charlotte Kletchka
 NOTARY PUBLIC
 CHARLOTTE KLETCHKA

