

CARD MUST BE TYPED

State of Kansas
NOTICE OF INTENTION TO DRILL
(see rules on reverse side)

CARD MUST BE SIGNED

Starting Date: 5-22-85
month day year

API Number 15- 179,20,810-~~6006~~ **CORRECTED** 4-2585

OPERATOR: License # 5011
Name Viking Resources
Address 217 E. William
City/State/Zip Wichita, KS 67202-4005
Contact Person Jim Devlin
Phone 316-262-2502

* SE SE NE .. Sec 12.. Twp .9.. S, Rge .28. East
(location) West

..... 297.0 .. Ft North from Southeast Corner of Section
..... 330 .. Ft West from Southeast Corner of Section
(Note: Locate well on Section Plat on reverse side)

CONTRACTOR: License # 5420
Name White and Ellis Drilling, Inc.
City/State Wichita, KS

Nearest lease or unit boundary line 330 feet.
County Sheridan
Lease Name Yowell Well# 4

Well Drilled For: Well Class: Type Equipment:
 Oil Swd Infield Mud Rotary
 Gas Inj Pool Ext. Air Rotary
 OWWO Expl Wildcat Cable

Domestic well within 330 feet : yes no
Municipal well within one mile : yes no

If OWWO: old well info as follows:

Operator
Well Name
Comp Date Old Total Depth
Projected Total Depth 4050 feet
Projected Formation at TD BKC
Expected Producing Formations LKC

Depth to Bottom of fresh water 200 feet
Lowest usable water formation Dakota
Depth to Bottom of usable water 1500 feet
Surface pipe by Alternate : 1 2
Surface pipe to be set 280 feet
Conductor pipe if any required None feet
Ground surface elevation 2690 feet MSL
This Authorization Expires 10-16-85
Approved By 4-16-85

I certify that we will comply with K.S.A. 55-101, et seq., plus eventually plugging hole to K.C.C. specifications.

kwqs. S ESE NW

Date 22 April 1985

Signature of Operator or Agent


Title

Partner

**Must be filed with the K.C.C. five (5) days prior to commencing well
This card void if drilling not started within six (6) months of date received by K.C.C.**

Important procedures to follow :

**A Regular Section of Land
1 Mile = 5,280 Ft.**

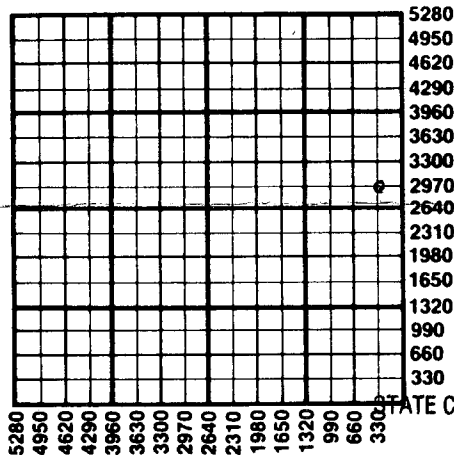

1. Notify District office before setting surface casing.
2. Set surface casing by circulating cement to the top.
3. File completion forms ACO-1 with K.C.C. within 90 days of well completion, following instructions on ACO-1, side 1, and including copies of wireline logs.
4. Notify District office 48 hours prior to old well workover or re-entry.
5. Prior to plugging, prepare a plugging plan, then obtain agreement from the appropriate district office for an approved plugging plan.
6. Submit plugging report (CP-4) to K.C.C. after plugging is completed.
7. Obtain an approved injection docket number before disposing of salt water.
8. Notify K.C.C. within 10 days when injection commences or terminates.
9. If an alternate 2 completion, cement in the production pipe from below any usable water to surface within 120 days of spud date.

RECEIVED
STATE CORPORATION COMMISSION

4-24-85
APR 24 1985

CONSERVATION DIVISION
Wichita, Kansas

State Corporation Commission of Kansas
Conservation Division
200 Colorado Derby Building
Wichita, Kansas 67202
(316) 263-3238