

CARD MUST BE TYPED

State of Kansas
NOTICE OF INTENTION TO DRILL
(see rules on reverse side)

CARD MUST BE SIGNED

Starting Date: 1 10 85
month day year

API Number 15- 193-20,340-0000

OPERATOR: License # 7506
Name First Energy Corporation
Address 16701 Greenspoint Park Dr., St. 200
City/State/Zip Houston, TX 77060
Contact Person Bill Dean
Phone 713-847-5755

C. SW SW SW Sec 23 Twp 9 S, Rge 32
(location) East West

330 Ft North from Southeast Corner of Section
4950 Ft West from Southeast Corner of Section
(Note: Locate well on Section Plat on reverse side)

CONTRACTOR: License # 6033
Name Murfin Drilling Company
City/State Wichita, KS 67202

Nearest lease or unit boundary line 330 feet.
County Thomas
Lease Name Father Gesenhues Trust Well# 18-23

Domestic well within 330 feet: yes no
Municipal well within one mile: yes no

Well Drilled For: **Well Class:** **Type Equipment:**
 Oil Swd Infield Mud Rotary
 Gas Inj Pool Ext. Air Rotary
 OWWO Expl Wildcat Cable


Depth to Bottom of fresh water 150 205 mhc feet
Lowest usable water formation Dakota
Depth to Bottom of usable water ~~1650~~ 1800 mhc feet
Surface pipe by Alternate: 1 2
Surface pipe to be set 300 feet
Conductor pipe if any required N/A feet
Ground surface elevation --- feet MSL
This Authorization Expires 6-28-85
Approved By P.H./K.C. 12-28-84

If OWWO: old well info as follows:

Operator
Well Name
Comp Date Old Total Depth
Projected Total Depth 4700 feet
Projected Formation at TD Miss.
Expected Producing Formations Miss.

I certify that we will comply with K.S.A. 55-101, et seq., plus eventually plugging hole to K.C.C. specifications.

Date 12-28-84 Signature of Operator or Agent

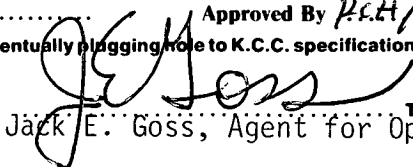
Jack E. Goss, Agent for Operator Title Ass't. Drilling Manager

mhc/KDHE 12/28/84


Must be filed with the K.C.C. five (5) days prior to commencing well
This card void if drilling not started within six (6) months of date received by K.C.C.

Wichita, Kansas
CONSERVATION DIVISION

12-28-84

DEC 28 1984

RECEIVED
STATE CORPORATION COMMISSION
A Regular Section of Land

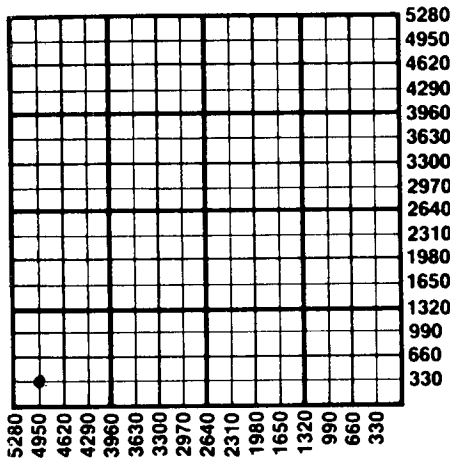

Important procedures to follow :

1. Notify District office before setting surface casing.
2. Set surface casing by circulating cement to the top.
3. File completion forms ACO-1 with K.C.C. within 90 days of well completion, following instructions on ACO-1, side 1, and including copies of wireline logs.
4. Notify District office 48 hours prior to old well workover or re-entry.
5. Prior to plugging, prepare a plugging plan, then obtain agreement from the appropriate district office for an approved plugging plan.
6. Submit plugging report (CP-4) to K.C.C. after plugging is completed.
7. Obtain an approved injection docket number before disposing of salt water.
8. Notify K.C.C. within 10 days when injection commences or terminates.
9. If an alternate 2 completion, cement in the production pipe from below any usable water to surface within 120 days of spud date.

State Corporation Commission of Kansas
Conservation Division
200 Colorado Derby Building
Wichita, Kansas 67202
(316) 263-3238