

STATE OF KANSAS  
STATE CORPORATION COMMISSION


Give All Information Completely  
Make Required Affidavit  
Mail or Deliver Report to:  
Conservation Division  
State Corporation Commission  
211 No. Broadway  
Wichita, Kansas

WELL PLUGGING RECORD

Trego County, Sec. 34 Twp. 11S Rge. 24 (E) ~~WW~~(W)

Location as "NE/CNW\*SW\*" or footage from lines C E2 E2 NW4  
Lease Owner Glickman Oil Company  
Lease Name Schultz Well No. 1  
Office Address 702 S. St. Francis, - Wichita, Kansas  
Character of Well (completed as Oil, Gas or Dry Hole) Dry Hole  
Date well completed 4-18-67 19  
Application for plugging filed 4-18-67 19  
Application for plugging approved 4-18-67 19  
Plugging commenced 4-18-67 19  
Plugging completed 4-18-67 19  
Reason for abandonment of well or producing formation \_\_\_\_\_

NORTH

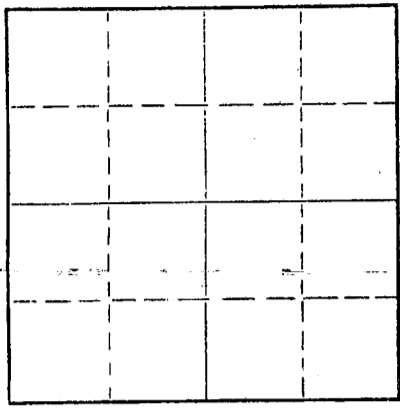

Locate well correctly on above Section Plat

If a producing well is abandoned, date of last production \_\_\_\_\_ 19  
Was permission obtained from the Conservation Division or its agents before plugging was commenced? yes

Name of Conservation Agent who supervised plugging of this well Mr. W. L. Nichols - Morland, Kansas  
Producing formation \_\_\_\_\_ Depth to top \_\_\_\_\_ Bottom \_\_\_\_\_ Total Depth of Well 3876' Feet  
Show depth and thickness of all water, oil and gas formations.


OIL, GAS OR WATER RECORDS

CASING RECORD

FORMATION	CONTENT	FROM	TO	SIZE	PUT IN	PULLED OUT
				8 5/8"	207'	

Describe in detail the manner in which the well was plugged, indicating where the mud fluid was placed and the method or methods used in introducing it into the hole. If cement or other plugs were used, state the character of same and depth placed, from \_\_\_\_\_ feet to \_\_\_\_\_ feet for each plug set.

Set plug @ 600' W/20 sx cement through drill pipe, mud to 210' plug & 1/2 sx hulls & rock bridge W/20 sx cement. Mud to 40' plug & 1/2 sx hulls, 10 sx cement 2 sx cement in rathole.

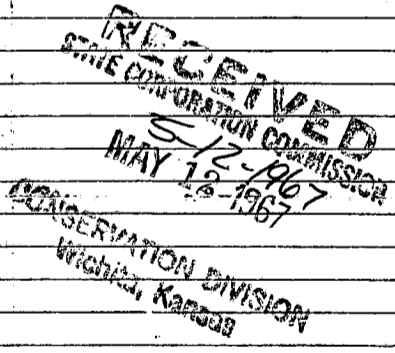

(If additional description is necessary, use BACK of this sheet)

Name of Plugging Contractor Glickman Oil Company  
Address 702 S. St. Francis - Wichita, Kansas

STATE OF Kansas, COUNTY OF Sedgwick, ss.  
Milton Glickman (employee or owner or operator) of the above-described well, being first duly sworn on oath, says: That I have knowledge of the facts, statements, and matters herein contained and the log of the above-described well as filed and that the same are true and correct. So help me God.

(Signature) [Signature]  
702 S. St. Francis - Wichita, Kansas  
(Address)

SUBSCRIBED AND SWORN TO before me this 4th day of May 19 67



November 19, 1967  
Lorella Schauf Notary Public.

15-195-20014-00-00

GLICKMAN OIL COMPANY  
P.O. Box 3104  
Wichita, Kansas 67211

DRILLERS WELL LOG

Company: Glickman Oil Company Location: C E2 E2 NW4 34-11S-24W  
Trego County, Kansas  
Farm: Schultz Well No. 1 Elevation: 2508 KB  
Commenced: 4-10-67 Geologist: Irwin Kornfeld  
Completed: 4-18-67 Production: D&A  
Total Depth: 3876  
Casing 8 5/8" @207' W/160 Sacks

Figures Indicate Bottom of Formations

		TOPS
75	Surface Soil W/Sand Stringers	
100	Shale	
185	Trego County	Anhydrite 2095
207	Cement	Heebner 3853 - 1345
335	Shale	
1275	Blue Shale	
1420	Sand & Shale	
1630	Shale	
1725	Sand & Shale	
2085	Shale	
2130	Anhydrite	
2510	Shale	
2760	Shale W/Lime Streaks	
2960	Shale & Lime	
3540	Lime & Shale	
3785	Shale & Lime	
3874	Lime & Shale	
3876	RTD	

STATE OF KANSAS  
MAY 18 1967  
CONSERVATION DIVISION  
Wichita, Kansas

STATE OF KANSAS, COUNTY OF SEDGWICK, ss:

I, Milton Glickman of the Glickman Oil Company, upon oath state that the above and foregoing is a true and correct copy of the log of the Schultz #1

*Milton Glickman*

Milton Glickman

Subscribed and sworn to before me this 4th day of May, 1967

*Lorella Schauf*

Lorella Schauf

Notary Public

My Commission Expires: November 19, 1967

