


Give All Information Completely
Make Required Affidavit
Mail or Deliver Report to:
Conservation Division
State Corporation Commission
211 No. Broadway
Wichita, Kansas

WELL PLUGGING RECORD

TREGO County, Sec. 35 Twp. 11S Rge. 24 ~~(S)~~XXXXX(W)

Location as "NE/CNW&SW&" or footage from lines NW SW SW
Lease Owner EMPIRE DRILLING COMPANY
Lease Name MUSSEMANN Well No. 1
Office Address 650 FOURTH NATIONAL BANK BLDG., WICHITA 2, KANSAS
Character of Well (completed as Oil, Gas or Dry Hole) DRY HOLE
Date well completed July 24 19 62
Application for plugging filed July 24 19 62
Application for plugging approved July 24 19 62
Plugging commenced July 24 19 62
Plugging completed July 24 19 62
Reason for abandonment of well or producing formation DRY HOLE

NORTH

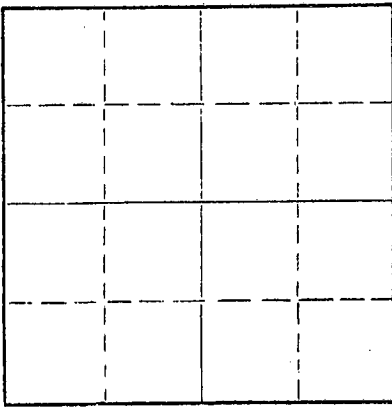

Locate well correctly on above Section Plat

If a producing well is abandoned, date of last production _____ 19 ____
Was permission obtained from the Conservation Division or its agents before plugging was commenced? yes

Name of Conservation Agent who supervised plugging of this well Eldon Petty
Producing formation _____ Depth to top _____ Bottom _____ Total Depth of Well 4050' Feet
Show depth and thickness of all water, oil and gas formations.

OIL, GAS OR WATER RECORDS

CASING RECORD

FORMATION	CONTENT	FROM	TO	SIZE	PUT IN	PULLED OUT
Surface	Sand & Shale	0	134	8 5/8	128'	-0-

Describe in detail the manner in which the well was plugged, indicating where the mud fluid was placed and the method or methods used in introducing it into the hole. If cement or other plugs were used, state the character of same and depth placed, from _____ feet to _____ feet for each plug set.

Plug set at 540' with 20 sacks
Plug set at 150' with 20 sacks
Plug set at 35' with 10 sacks

RECEIVED
STATE CORPORATION COMMISSION
8-6-1962
AUG 6 1962
CONSERVATION DIVISION
Wichita, Kansas

(If additional description is necessary, use BACK of this sheet)

Name of Plugging Contractor EMPIRE DRILLING COMPANY
Address 650 FOURTH NATIONAL BANK BLDG., WICHITA 2, KANSAS

STATE OF KANSAS, COUNTY OF SEDGWICK, ss.
Dan J. Kornfeld (owner or operator) of the above-described well, being first duly sworn on oath, says: That I have knowledge of the facts, statements, and matters herein contained and the log of the above-described well as filed and that the same are true and correct. So help me God.

(Signature) Dan J. Kornfeld
650 FOURTH NATIONAL BANK BLDG., WICHITA, KANSAS
(Address)

SUBSCRIBED AND SWORN to before me this 30th day of July, 19 62

My Commission Expires Oct. 21, 1962
My commission expires _____

Lucille W. Harr
Notary Public.



LOG

COMPANY: Empire Drilling Company
 CONTRACTOR: Empire Drilling Company
 FARM: Mussemann # 1
 LOCATION: NW SW SW Section 35-11S-24W, Trego County, Kansas
 COMMENCED: July 15, 1962 ELEVATION: 2488 KB
 COMPLETED: July 24, 1962 POTENTIAL: D & A

* * * * *

0	to	134	Surface Sand & Shale
134	to	1350	Shale-Shells-Pyrite
1350	to	2068	Shale & Shells
2068	to	2104	Anhydrite
2104	to	2650	Shale & Shells
2650	to	2780	Shale
2780	to	3210	Lime & Shale
3210	to	3272	Lime
3272	to	3820	Lime & Shale
3820	to	3851	Lime
3851	to	3905	Lime & Shale
3905	to	3955	Lime & Chert
3955	to	4035	Lime
4035	to	4050	Lime & Shale
4050			Rotary Total Depth

SET: 128' of 8 5/8" casing with 100 Sacks Cement.

ELECTRIC LOG TOPS:

ANHYDRITE	2066	+ 422
HEEBNER	3819	-1331
TORONTO	3840	-1352
LANSING-KANSAS CITY	3856	-1368
WELEX TOTAL DEPTH	4049	

RECEIVED
 STATE CORPORATION COMMISSION
 8-6-1962
 AUG 6 1962
 CONSERVATION DIVISION
 Wichita, Kansas

* * * * *

CERTIFICATION

I, Dan J. Kornfeld, do hereby certify that the above and foregoing is a true and correct copy of the log on the Mussemann # 1, NW SW SW of Section 35-11S-24W, Trego County, Kansas, as reflected by the files of Empire Drilling Company.

Dan J. Kornfeld
 DAN J. KORNFELD

Subscribed and sworn to before me, a Notary Public, within and for Sedgwick County, Kansas, this 31st day of July, 1962.

Lucille H. Harr
 LUCILLE H. HARR, Notary Public



My commission expires October 21, 1962.