

15-195-20917-00-00

STATE OF KANSAS
STATE CORPORATION COMMISSION

WELL PLUGGING RECORD

Give All Information Completely
Make Required Affidavit
Mail or Deliver Report to
Conservation Division
State Corporation Comm.
245 North Water
Wichita, KS 67202

Trego County, Sec. 3 Twp. 11S Rge. 25 E/W
Location as "NE/CNW/SW 1/4" or footage from lines
NE SW SE


Lease Owner Murjo Oil & Royalty Company
Lease Name Gerstner Well No. #1
Office Address P. O. Box 12666, Ft. Worth, Texas 76116
Character of Well (Completed as Oil, Gas or Dry Hole)
Dry Hole

Date Well completed 1-5-82 19
Application for plugging filed 1-4-82 19
Application for plugging approved 1-4-82 19
Plugging commenced 1-4-82 19
Plugging completed 1-5-82 19

Reason for abandonment of well or producing formation
Commercial quantities of oil not found
If a producing well is abandoned, date of last production 19.

Was permission obtained from the Conservation Division or its agents before plugging was commenced? Yes

Name of Conservation Agent who supervised plugging of this well Marion Schmidt
Producing formation _____ Depth to top _____ Bottom _____ Total Depth of Well 4220'
Show depth and thickness of all water, oil and gas formations.

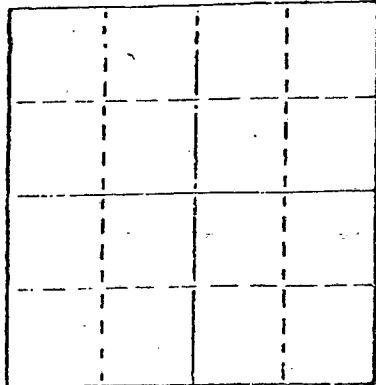

OIL, GAS OR WATER RECORDS

CASING RECORD

FORMATION	CONTENT	FROM	TO	SIZE	PUT IN	PULLED OUT
				8 5/8"	263'	None

Describe in detail the manner in which the well was plugged, indicating where the mud fluid was placed and the method or methods used in introducing it into the hold. If cement or other plugs were used, state the character of same and depth placed, from _____ feet to _____ feet for each plug set.

Plug @ 1230' w/70 sx.
Plug @ 250' w/40 sx.
Plug @ 40' w/10 sx.
Rat Hole 10 sx.

RECEIVED
STATE CORPORATION COMMISSION

1-18-1982

(If additional description is necessary, use BACK of this sheet)

Name of Plugging Contractor Buffalo Drilling Company, Inc.

CONSERVATION DIVISION
Wichita Kansas

STATE OF Kansas COUNTY OF Sedgwick, ss.

Jerald W. Rains, President of Buffalo Drilling Company, (employee of owner) or (owner or operator) of the above-described well, being first duly sworn on oath, says: That I have knowledge of the facts, statements, and matters herein contained and the log of the above-described well as filed and that the same are true and correct. So help me God.

(Signature)

435 Page Court, 220 W. Douglas, Wichita, Ks. 67202
(Address)

SUBSCRIBED AND SWORN TO before me this 7 day of January, 19 82

My commission expires 10-4-83

Juanita M. Green Notary Public.



DRILLER'S LOG

COMPANY: Murjo Oil & Royalty Company

SEC. 3 T. 11S R. 25W

WELL NAME: Gerstner #1

LOC. NE SW SE

COUNTY: Trego

RIG NO. #7

TOTAL DEPTH 4220'

ELEVATION

COMMENCED: 12-27-81 COMPLETED: 1-5-82

CONTRACTOR: Buffalo Drilling Company, Inc.

CASING RECORD:

SURFACE: 8 5/8" @ 263' w/165 sx. 60/40 poz., 3% cc., 2% gel.

PRODUCTION: D&A

LOG

(Figures Indicate Bottom of Formations)

Shale & Sand	333
Sand & Shale	1894
Shale & Lime	2319
Shale	2369
Shale & Lime	2794
Shale	3150
Shale & Lime	3210
Lime & Shale	3359
Shale & Lime	3848
Lime	4013
Shale & Lime	4130
Lime	4220
<u>ROTARY TOTAL DEPTH</u>	<u>4220</u>

RECEIVED
 STATE CORPORATION COMMISSION
 1-18-1982
 JAN 18 1982
 CONSERVATION DIVISION
 Wichita, Kansas

STATE OF Kansas)

COUNTY OF Sedgwick)

SS:

I, Jerald W. Rains, President of Buffalo Drilling Company, Inc.


upon oath state that the above and foregoing is a true and correct copy of the log of the Gerstner #1 well.


 Jerald W. Rains

Subscribed and sworn to before me this 7 day of January, 1982.

My Appointment Expires:

10-4-83

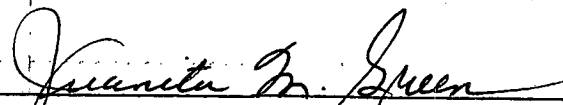
 Juanita M. Green

