


STATE OF KANSAS
STATE CORPORATION COMMISSION

WELL PLUGGING RECORD

Give All Information Completely
Make Required Affidavit
Mail or Deliver Report to
Conservation Division
State Corporation Comm.
245 North Water
Wichita, KS 67202

Trego County, Sec. 10 Twp. 11S Rge. 25 ~~NE~~/W
Location as "NE/CNW\SW" or footage from lines
SW SE SE
Lease Owner Liberty Enterprises
Lease Name Gerstner Well No. #1
Office Address 308 West Mill Plainville, KS 67663
Character of Well (Completed as Oil, Gas or Dry Hole)

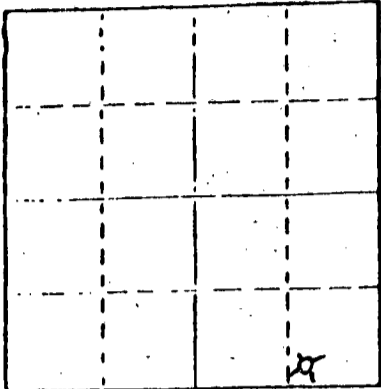

Locate well correctly on above
Section Plat

Dry Hole
Date Well completed July 1 1980
Application for plugging filed July 1 1980
Application for plugging approved July 1 1980
Plugging commenced July 1 8:30 A.M. 1980
Plugging completed July 1 10:00 A.M. 1980
Reason for abandonment of well or producing formation
No Commercial Production
If a producing well is abandoned, date of last production 19

Was permission obtained from the Conservation Division or its agents before plugging was commenced? yes
Name of Conservation Agent who supervised plugging of this well Gil Balthazor
Producing formation _____ Depth to top _____ Bottom _____ Total Depth of Well 4100'
Show depth and thickness of all water, oil and gas formations.

OIL, GAS OR WATER RECORDS

CASING RECORD

FORMATION	CONTENT	FROM	TO	SIZE	PUT IN	PULLED OUT
surface casing	common	0	193.17	8 5/8"	193.17	0

Describe in detail the manner in which the well was plugged, indicating where the mud fluid was placed and the method or methods used in introducing it into the hold. If cement or other plugs were used, state the character of same and depth placed, from _____ feet to _____ feet for each plug set.

Plug #1 @ 990' with 60 sxs
Plug #2 @ 180' with 30 sxs
Plug #3 @ 41' with 15 sxs hulls & 10 sx
5 sxs in rathole
50-50 pozz6% gel
completed at 10:00 P.M.

RECEIVED
STATE CORPORATION COMMISSION
7-10-1980
JUL 10 1980
CONSERVATION DIVISION
Wichita, Kansas

(If additional description is necessary, use BACK of this sheet)

Name of Plugging Contractor Pioneer Drilling Company, Inc.
308 W. Mill Plainville, Kansas 67663

STATE OF Kansas COUNTY OF Rooks, ss.
Roger L. Comeau (employee of owner) or (owner or operator)
of the above-described well, being first duly sworn on oath, says: That I have knowledge of the facts, statements, and matters herein contained and the log of the above-described well as filed and that the same are true and correct. So help me God.


(Signature)

308 West Mill Plainville, KS 67663
(Address)

SUBSCRIBED AND SWORN TO before me this 9th day of July, 1980

Notary Public.

My commission expires

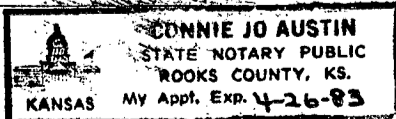

WELL LOG

OPERATOR: Liberty Enterprises

WELL NAME: Gerstner #1 LOCATION: SW SE SE 10-11S-25W

COUNTY: Trego STATE: Kansas

WELL COMMENCED: June 23, 1980 WELL COMPLETED: July 1, 1980

ELEVATION: 2492' K.B. TOTAL DEPTH: 4100'

PRODUCTION: D & A RIG NO: #2

CASING - 8-5/8": 193.17' of used 28# cemented with 100 sxs common 3% cc 2% gel cement circ
5-1/2": none

ALL MEASUREMENTS TAKEN FROM THE TOP OF ROTARY BUSHING:

FROM	TO	FORMATION	DEVIATION FROM VERTICAL	REMARKS:
0'	202'			
202'	1099'	sand and Post Rock, shale		
1099'	1130'	sand and shale		
1130'	2070'	sand and shale		
2070'	2080'	sand and shale		
2081'	2123'	Anhydrite		
2123'	2246'	sand and shale		
2246'	2563'	shale and sand	2246' - 1 degree	
2563'	2810'	sand and shale		
2810'	2991'	shale and lime		
2991'	3220'	shale and lime		
3220'	3372'	shale and lime		
3372'	3509'	shale and lime		
3509'	3648'	shale and lime		
3648'	3768'	shale and lime		
3768'	3849'	lime and shale		
3849'	3872'	lime and shale		
3872'	3872'		3872' - 1 1/2 degrees	
3872'	3895'	shale and lime		
3895'	3906'	shale and lime		
3906'	3927'			
3927'	3965'	shale and lime		
3965'	4010'	shale and lime		
4010'	4065'	shale and lime		
4065'	4100'			
4100'	RTD			

RECEIVED
STATE CORPORATION COMMISSION
7-10-1980
JUL 10 1980
CONSERVATION DIVISION
Wichita, Kansas

STATE OF KANSAS
COUNTY OF

The undersigned hereby certifies that to the best of his knowledge and belief, the above facts are true and correct

PIONEER DRILLING CO., INC.

By Roger L. Gorman

SUBSCRIBED AND SWORN TO, BEFORE ME, This 9th day of July, 1980

Connie Jo Austin
NOTARY PUBLIC

