


WELL PLUGGING RECORD

Give All Information Completely
Make Required Affidavit
Mail or Deliver Report to:
Conservation Division
State Corporation Commission
212 No. Market
Wichita, Kansas

Trego County, Sec. 11 Twp. 11 Rge. (E) 25 (W)

Location as "NE/CNW%SW%" or footage from lines NE-SE-NE
Lease Owner Mack Oil Co.
Lease Name R. N. Tidball Well No. 1
Office Address Box 400, Duncan, Oklahoma 73533
Character of Well (completed as Oil, Gas or Dry Hole) Dry hole
Date well completed Aug. 18 19 77
Application for plugging filed (oral) Aug. 18 19 77
Application for plugging approved Aug. 18 19 77
Plugging commenced Aug. 18 19 77
Plugging completed Aug. 18 19 77
Reason for abandonment of well or producing formation dry hole

NORTH

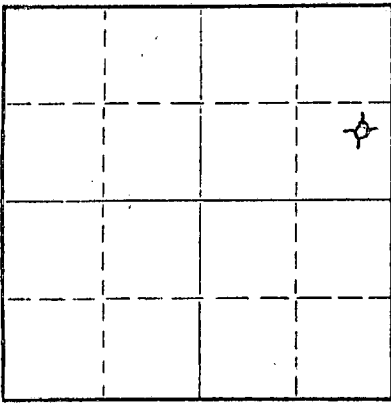

Locate well correctly on above
Section Plat

If a producing well is abandoned, date of last production none 19
Was permission obtained from the Conservation Division or its agents before plugging was commenced? yes

Name of Conservation Agent who supervised plugging of this well Gilbert Baltazor
Producing formation Depth to top Bottom Total Depth of Well 3965 Feet
Show depth and thickness of all water, oil and gas formations.

OIL, GAS OR WATER RECORDS

CASING RECORD

FORMATION	CONTENT	FROM	TO	SIZE	PUT IN	PULLED OUT
Surface		0	213	8 5/8		

Describe in detail the manner in which the well was plugged, indicating where the mud fluid was placed and the method or methods used in introducing it into the hole. If cement or other plugs were used, state the character of same and depth placed, from feet to feet for each plug set.

First Plug at 900' with 70 sacks 50-50 poz 6% gel
Second plug at 200' with 20 sacks 50-50 poz 6% gel
Build bridge at 40' and plug with 10 sacks 50-50 poz 6% gel to surface

RECEIVED
STATE CORPORATION COMMISSION
8-26-1977
AUG 26 1977
CONSERVATION DIVISION
Wichita, Kansas


(If additional description is necessary, use BACK of this sheet)

Name of Plugging Contractor Halliburton Services
Address P. O. Box 339, Hays, Kansas 67601

STATE OF Kansas, COUNTY OF Graham, ss.
Jerry M. Helberg (employee of owner) or (owner or operator) of the above-described well, being first duly sworn on oath, says: That I have knowledge of the facts, statements, and matters herein contained and the log of the above-described well as filed and that the same are true and correct. So help me God.

(Signature) Jerry M. Helberg
Box 32, Morland, Kansas 67650
(Address)

SUBSCRIBED AND SWORN TO before me this 24th day of August, 19 77

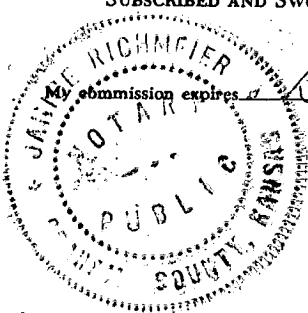

Janice Richmond
Notary Public.

15-195-20420-00-00

DRILLERS LOG

R. N. TIDBALL #1

CASING RECORD:

OPERATOR: Mack Oil Company

8 5/8" set at 213'

CONTRACTOR: Helberg Oil Company

TOTAL DEPTH:

COMMENCED: August 9, 1977

3965'

COMPLETED: August 19, 1977

DESCRIPTION:

NE SE NE
Sec. 11-11s-25w, Trego County, Kansas

FORMATION	FROM	TO	REMARKS
Sand	0	230	
Sand & Shale	230	1160	
Sand & Shale	1160	1727	
Sand & Shale	1727	1964	
Anhydrite	1964	2005	
Shale	2005	2034	
Shale	2034	2375	
Shale	2375	2550	
Shale	2550	2635	
Shale	2635	2768	
Shale	2768	2954	
Shale	2954	3094	
Shale	3094	3194	
Shale	3194	3290	
Shale	3290	3435	
Shale	3435	3470	
Shale	3470	3585	
Shale & Lime	3585	3688	
Shale & Lime	3688	3760	
Shale & Lime	3760	3823	
Lime	3823	3880	
Lime	3880	3900	
Lime	3900	3920	
Lime	3920	3945	
Lime	3945	3965	
T.D.	3965		D & A

RECEIVED
 CONSERVATION COMMISSION
 8-26-1977
 AUG 26 1977
 CONSERVATION DIVISION
 Wichita, Kansas

I certify that this is a true and correct copy of the above log to the best of my knowledge.

HELBERG OIL COMPANY

Jerry M. Helberg
 Jerry M. Helberg

Subscribed and sworn to before me this 24 day of August, 1977.

James Robinson
 Notary Public

My commission expires Dec 4, 1979

