


STATE OF KANSAS
STATE CORPORATION COMMISSION

Give All Information Completely
Make Required Affidavit
Mail or Deliver Report to:
Conservation Division
State Corporation Commission
211 No. Broadway
Wichita, Kansas

WELL PLUGGING RECORD

15-163-01054-0000

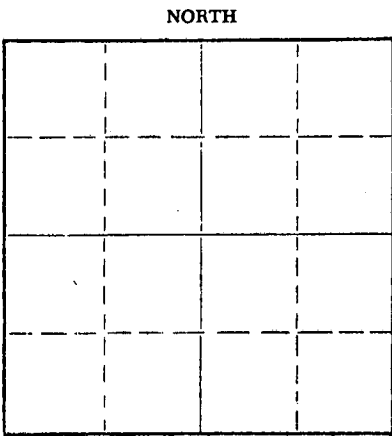

Locate well correctly on above
Section Plat

Rooks County, Sec. 15 Twp. 10S Rge. 16 (W)

Location as "NE/CNW/SW" or footage from lines C NW NW
Lease Owner Surray Mid-Continent Oil Company
Lease Name Serena Conger Well No. 1
Office Address P. O. Box 729, Great Bend, Kansas
Character of Well (completed as Oil, Gas or Dry Hole) Dry Hole
Date well completed March 19, 1962
Application for plugging filed March 19, 1962
Application for plugging approved March 19, 1962
Plugging commenced March 19, 1962
Plugging completed March 19, 1962
Reason for abandonment of well or producing formation _____

If a producing well is abandoned, date of last production _____ 19____
Was permission obtained from the Conservation Division or its agents before plugging was commenced? Yes

Name of Conservation Agent who supervised plugging of this well Mr. Eldon Petty
Producing formation _____ Depth to top _____ Bottom _____ Total Depth of Well 3617 Feet
Show depth and thickness of all water, oil and gas formations.

OIL, GAS OR WATER RECORDS

CASING RECORD

FORMATION	CONTENT	FROM	TO	SIZE	PUT IN	PULLED OUT

Describe in detail the manner in which the well was plugged, indicating where the mud fluid was placed and the method or methods used in introducing it into the hole. If cement or other plugs were used, state the character of same and depth placed, from _____ feet to _____ feet for each plug set.
Driller's Log Attached.

Cement plugs, consisting of Pozmix cement, were placed at:

- Plug #1 - 20 Sx at 500'
- Plug #2 - 20 Sx " 240'
- Plug #3 - 10 Sx " 40'

All intervals between plugs are filled with 10.0# mud ladden fluid.

RECEIVED
STATE CORPORATION COMMISSION
4-17-62
APR 17 1962
CONSERVATION DIVISION
Wichita, Kansas

(If additional description is necessary, use BACK of this sheet)

Name of Plugging Contractor Halliburton Company
Address Duncan, Oklahoma

STATE OF Kansas, COUNTY OF Barton, ss.
C. C. Shreve (employee of owner) or (owner or operator) of the above-described well, being first duly sworn on oath, says: That I have knowledge of the facts, statements, and matters herein contained and the log of the above-described well as filed and that the same are true and correct. So help me God.

(Signature) C. C. Shreve
District Manater, P. O. Box 729, Great Bend
(Address)

Subscribed and Sworn to before me this 16th day of April, 19 62

My commission expires February 7, 1966

Emogene Akens
Notary Public.



612-41

15-163-01054-0000

Sunray Mid-Continent Oil Company
Tulsa, Oklahoma

Tulsa, Oklahoma
March 21, 1962

Contractor: Stickle Drilling Company
Date Commenced: March 9, 1962
Date Completed: March 19, 1962

Serena Conger, Well No. 1
Ctr. NW NW Sec. 15-10S-16W
Rooks County, Kansas

DRILLER'S LOG

Depth Figures Indicate Base of Formation:

Post rock and shale	113
Shale and post rock	195
Shale	225
Shale and shells	375
Red bed and sand	725
Anhydrite	782
Shale and sand	1201
Shale	1212
Anhydrite	1273
Shale	1485
Shale and shells	2115
Lime and shale	2143
Shale	2205
Lime	2295
Shale and lime	2456
Lime w/shale streaks	2583
Lime and shale	2680
Shale	2880
Shale and lime	2942
Lime	3017
Lime and shale	3105
Lime	3414
Lime and shale	3475
Lime	3610
Lime & cherty lime	3617 TD

RECEIVED
 STATE OF KANSAS
 CONSERVATION DIVISION
 WICHITA
 APR 1, 1962

I, Fred E. Stickle, hereby certify the above to be a true and complete Driller's Log of Sunray Mid-Continent Oil Company's Serena Conger, Well No. 1, Center of NW/4 NW/4 of Section 15-10S-16W., Rooks County, Kansas.

Fred E. Stickle
FRED E. STICKLE

Edith A. Lawver

Notary Public

My Commission expires March 24, 1964.

