

STATE OF KANSAS
 STATE CORPORATION COMMISSION
 200 Colorado Derby Bldg.
 Wichita, Kansas 67202


~~15-163-21733-0000~~
 15-163-21733-
 00-00

Form CP-4
 Rev. 12-15-80

WELL PLUGGING RECORD

Give All Information Completely
 Make Required Affidavit

COUNTY Rooks SEC. 16 TWP. 10S RGE. 16 E/W
 Location as in quarters or footage from lines:
100' S of NE SE NW

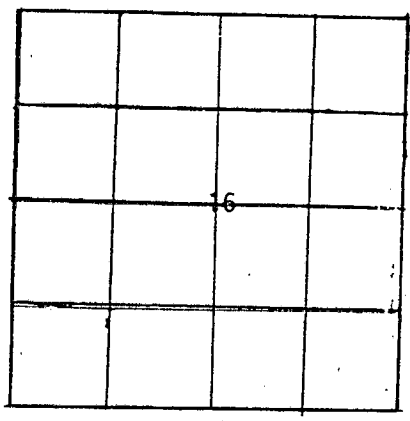

Locate Well
 correctly on above
 Section Platt.

Lease Owner Raymond Oil Company
 Lease Name Lenna Well No. 1
 Office Address One Main Place - Suite 900, Wichita, KS 67202
 Character of Well (Completed as Oil, Gas or Dry Hole): D&A
 Date Well Completed _____
 Application for plugging filed September 19, 1982
 Plugging commenced September 20, 1982
 Plugging completed September 20, 1982
 Reason for abandonment of well or producing formation
D&A

Was permission obtained from the Conservation Division or it's
 Agent's before plugging was commenced? Yes

Name of Conservation Agent who supervised plugging of this well Gilbert Scheck

Producing formation n/a Depth to top n/a bottom n/a T.D. 3590'

Show depth and thickness of all water, oil and gas formations.

OIL, GAS OR WATER RECORDS

Casing Record

| Formation | Content | From | To | Size | Put in | Pulled Out |
|-----------|---------|------|----|--------|--------|------------|
| | | | | 8-5/8" | 281.9' | -0- |
| | | | | | 289' | |
| | | | | | 27.0' | |

Describe in detail the manner in which the well was plugged, indicating where the mud
 fluid was placed and the method or methods used in introducing it into the hold. If cement
 or other plugs were used, state the character of same and depth placed, from _____ feet
 to _____ feet for each plug set.

Hole Plugged
 1st @ 780' w/100 sx
 2nd @ 300' w/40 sx
 1/2 sx hulls & plug @ 40' w/10 sx to surface
 10 sx in rathole
 Cmt w/160 sx 50-50 pozmix, 5% Gel, 3% C.C
 Allied Cementing Company

(If additional description is necessary, use BACK of this sheet)

Name of Plugging Contractor Allied Cementing Company
Box 31, 332 W. Wichita, Russell, KS 67665

STATE OF KANSAS COUNTY OF SEDGWICK, ss.
Pat R. Raymond (employee of owner) or (owner or operator) of the
 above-described well, being first duly sworn on oath, says: That I have knowledge of the
 facts, statements, and matters herein contained and the log of the above-described well as
 filed and that the same are true and correct. So help me God.
 RAYMOND OIL COMPANY, INC.

(Signature) Pat R. Raymond
Pat R. Raymond - Vice-President
One Main Place, Suite 900
Wichita, Kansas 67202

SUBSCRIBED AND SWORN TO before me this 29th day of September, 19 82

Kathleen Pipes
 Kathleen Pipes - Notary Public.

My Commission expires: March 22, 1983

