


Give All Information Completely
Make Required Affidavit
Mail or Deliver Report to:
Conservation Division
State Corporation Commission
211 No. Broadway
Wichita, Kansas

WELL PLUGGING RECORD

Rooks County, Sec. 34 Twp. 10S Rge. (E) 16 (W)

Location as "NE/CNW/SW" or footage from lines SE SE NE
Lease Owner Omega Drilling, Inc.
Lease Name #1 Nelson Well No. 1
Office Address 427 Union Center, Wichita, Kansas
Character of Well (completed as Oil, Gas or Dry Hole) Dry Hole
Date well completed December 31 1965
Application for plugging filed December 31 1965
Application for plugging approved December 31 1965
Plugging commenced December 31 1965
Plugging completed December 31 1965
Reason for abandonment of well or producing formation Dry Hole

NORTH

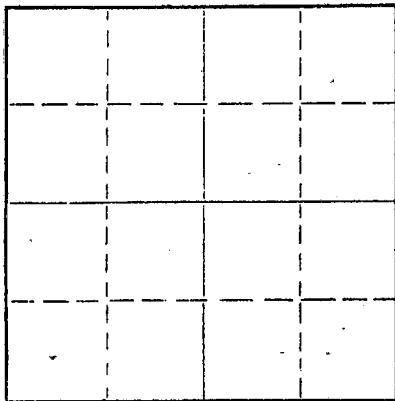

Locate well correctly on above
Section Plat

If a producing well is abandoned, date of last production 19
Was permission obtained from the Conservation Division or its agents before plugging was commenced? Yes

Name of Conservation Agent who supervised plugging of this well Mr. Gilbert Leiker
Producing formation Depth to top Bottom Total Depth of Well 3600 Feet
Show depth and thickness of all water, oil and gas formations.

OIL, GAS OR WATER RECORDS

CASING RECORD

FORMATION	CONTENT	FROM	TO	SIZE	PUT IN	PULLED OUT

Describe in detail the manner in which the well was plugged, indicating where the mud fluid was placed and the method or methods used in introducing it into the hole. If cement or other plugs were used, state the character of same and depth placed, from feet to feet for each plug set.

Plug set at 540' w/20 sx cmt; plug set at 220' w/25 sx cmt;
Plug set at 40' w/10 sx cmt.

RECEIVED
STATE CORPORATION COMMISSION
1-20-66
JAN 20 1966
CONSERVATION DIVISION
Wichita, Kansas

(If additional description is necessary, use BACK of this sheet)

Name of Plugging Contractor Halliburton Company
Address 4th Floor, Union Center, Wichita, Kansas

STATE OF Kansas, COUNTY OF Sedgwick, ss.
F. S. Woodside, Jr. (employee of owner) or (owner or operator) of the above-described well, being first duly sworn on oath, says: That I have knowledge of the facts, statements, and matters herein contained and the log of the above-described well as filed and that the same are true and correct. So help me God.

(Signature) F. S. Woodside, Jr.
427 Union Center, Wichita, Kansas
(Address)

SUBSCRIBED AND SWORN to before me this 19th day of January 1966
My commission expires January 8, 1968



Lois J. McCoy
Notary Public

ROTARY DRILLING LOG

Operator: Omega Drilling, Inc.
#1 Nelson
SE SE NE Sec. 34-10S-16W
Rooks County, Kansas

Contractor: Omega Drilling, Inc.
Commenced: December 17, 1965
Completed: December 31, 1965

Remarks: Set 8 5/8" surface casing @ 228' w/205 sx HA5

FORMATIONS

0 - 228	Top soil, Shale
228 - 921	Shale and Sand Streaks
921 - 1389	Shale and Anhydrite
1389 - 1905	Shale and Shells
1905 - 2131	Shale and Lime
2131 - 2285	Lime
2285 - 2450	Lime
2450 - 2730	Shale and Lime
2730 - 2972	Shale and Lime
2972 - 3055	Lime
3055 - 3150	Shale and Lime
3150 - 3185	Lime
3185 - 3270	Lime
3270 - 3330	Lime with Shale
3330 - 3345	Lime
3345 - 3400	Lime
3400 - 3478	Lime
3478 - 3539	Lime
3539 - 3577	Lime
3577 - 3600	Lime
3600 -	RTD

RECEIVED
STATE CORPORATION COMMISSION

JAN 21 1966

CONSERVATION DIVISION
WALTON, KANSAS

We certify that the above log is true and correct to the best of our knowledge and belief.

OMEGA DRILLING, INC.

F. S. Woodside, Jr.
Executive Vice-President

Subscribed and sworn to before me, a Notary Public, in and for the State of Kansas, County of Sedgwick, this 17th day of January, 1966

My commission expires January 8, 1968

Louis J. Lee

