KANSAS CORPORATION COMMISSION OIL & GAS CONSERVATION DIVISION


WELL PLUGGING APPLICATION

Please TYPE Form and File ONE Copy

Form CP-1 September 2003 This Form must be Typed Form must be Signed All blanks must be Filled

API #_ 15 - 153-20606-0000	(Identifier Number of this well). 1	This must be listed for wells drilled s	since 1967; if no API # was issued,
indicate original spud or completion date 05/85	·		
Well Operator: Murfin Drilling Company, Inc.		KCC License #: 30606	
Address: 250 N. Water, Suite 300	(/ Company Name)	_ _{City:} Wichita	(Operator's)
State: Kansas	Zip Code: 67202		67 - 3241
Lease: Celia South WF Unit	Well #:B-2	Sec. 29 Twp. 03	S. R. <u>36</u>
<u>NW - NE - NWsp</u>	ot Location / QQQQ County:	Rawlins	
Feet (in exact footage) From North / South (from nearest outside section comer) Line of Section (Not Lease Line) The feet (in exact footage) From East / West (from nearest outside section comer) Line of Section (Not Lease Line) Check One: Oil Well Gas Well D&A Cathodic Water Supply Well			
SWD Docket #			Ti
Conductor Casing Size:	Set at:	Cemented with:	Sacks
Surface Casing Size: 8 5/8	Set at: _379	Cemented with: 275	Sacks
Production Casing Size: 5 1/2	Set at: <u>4739</u>	Cemented with: 200	Sacks
List (ALL) Perforations and Bridgeplug Sets: Cherokee 4656'-4663' w/ 4 spf			
Elevation: 3296 (G.L. / VK.B.) T.D.: 4740	PBTD: 4723 Anhy	ydrite Depth:	ne Corral Formation)
Condition of Well: Good Poor	✓ Casing Leak Junk	k in Hole	io contain ormation,
Proposed Method of Plugging (attach a separate page if additional space is needed): Per KCC Requirements			
	***************************************		RECEIVED
			APR 2 8 2009
Is Well Log attached to this application as required?	Yes ✓ No Is ACO-1 filed?	✓ Yes No	
If not explain why?			KCC WICHITA
Plugging of this Well will be done in accordance with K.S.A. 55-101 et, seq. and the Rules and Regulations of the State Corporation Commission. List Name of Company Representative authorized to be in charge of plugging operations:			
Address: P.O. Box 661, 1040 Plains Ave.		_ City / State: Colby, KS 67701	<u> </u>
Plugging Contractor: Murfin Drilling Company, Inc.		KCC License #: 30606	
Address: 250 N. Water, Suite 300		_ Phone: (316) 267 -	3241
Proposed Date and Hour of Plugging (if known?): As soon as possible			
Payment of the Plugging Fee (K.A.R. 82-3-118) will be guaranteed by Operator or Agent			
Date: 4/24/09 Authorized Operator / A	Agent: // / /	(Signature)	- P'K

Mail to: KCC - Conservation Division, 130 S. Market - Room 2078, Wichita, Kansas 67202

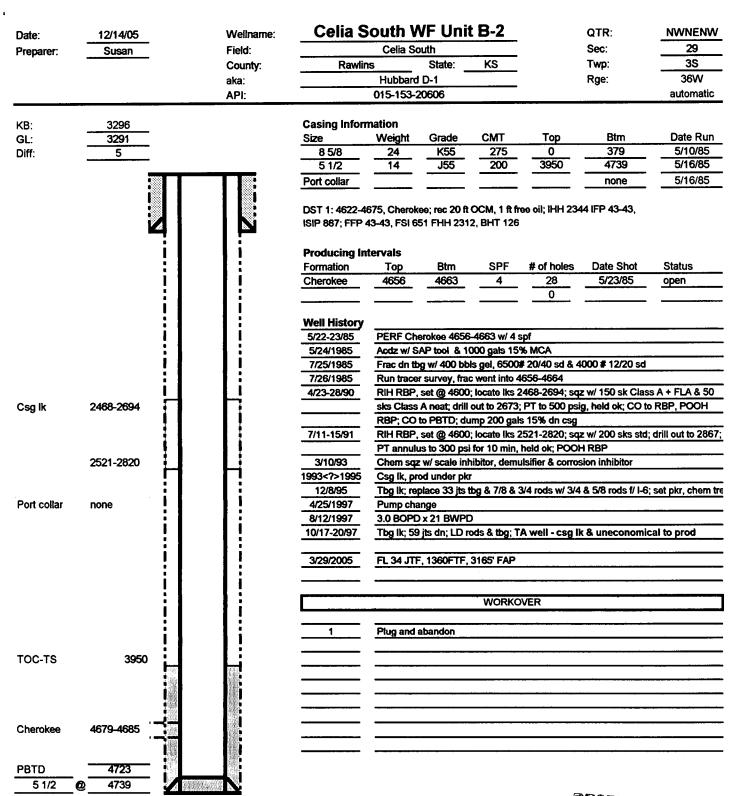

RECEIVED
APR 2 8 2000
KCC WICHITA



Kathleen Sebelius, Governor Thomas E. Wright, Chairman Michael C. Moffet, Commissioner Joseph F. Harkins, Commissioner

NOTICE OF RECEIPT OF WELL PLUGGING APPLICATION (CP-1)

MURFIN DRILLING CO., INC. 250 N WATER STE 300 WICHITA. KS 67202-1216 April 29, 2009

Re: CELIA SOUTH WF UNIT #B-2 API 15-153-20606-00-00 29-3S-36W, 4950 FSL 3630 FEL RAWLINS COUNTY, KANSAS

Dear Operator:

This letter is to notify you that the Conservation Division has received your plugging proposal, form CP-1, for the above well and has reviewed the proposal for completeness. The central office will now forward your CP-1 to the district office listed below for review of the proposed plugging method. Please contact the district office for approval of your proposed plugging method at least five (5) days before plugging the well, pursuant to K.A.R. 82-3-113(b). If a workover pit will be used during the plugging of the well it must be permitted. A CDP-1 form must be filed and approved prior to the use of the pit in accordance with K.A.R. 82-3-600.

The Conservation Division's review of form CP-1, either in the central or district office, does not include an inquiry into well ownership or the filing operator's legal right to plug the well. This notice in no way constitutes authorization to plug the above well by persons not having legal rights of ownership or interest in the well.

This notice is void after October 26, 2009. The CP-1 filing does not bring the above well into compliance with K.A.R. 82-3-111 with regard to the Commission's temporary abandonment requirements.

Sincerely,

Steve Rond

Steve Bond

Production Department Supervisor

District: #4 2301 E. 13th Hays, KS 67601 (785) 625-0550