

CARD MUST BE TYPED

State of Kansas
NOTICE OF INTENTION TO DRILL

(see rules on reverse side)

CARD MUST BE SIGNED

Starting Date: 4/15/85
month day year

OPERATOR: License # 5474
Name Northern Lights Oil Co.
Address 212 N. Market, Suite 400
City/State/Zip Wichita, Kansas 67202
Contact Person John W. Sutherland, Jr.
Phone (316) 263-1008

CONTRACTOR: License # 5651
Name Mallard Drilling Co., Inc.
City/State Wichita, Kansas 67202

Well Drilled For: Well Class: Type Equipment:

☒ Oil ☐ Swd ☐ Infield ☒ Mud Rotary
☐ Gas ☐ Inj ☐ Pool Ext. ☐ Air Rotary
☐ OWWO ☐ Expl ☒ Wildcat ☐ Cable

If OWWO: old well info as follows:

Operator
Well Name
Comp Date Old Total Depth
Projected Total Depth 3650 feet
Projected Formation at TD Arbuckle
Expected Producing Formations Lansing/KC, Conglomerate

I certify that we will comply with K.S.A. 55-101, et seq., plus eventually plugging hole to K.C.C. specifications.

Date 4/8/85 Signature of Operator or Agent

API Number 15- 163-22,663-0000

SE SE NW Sec 14 Twp 10 S, Rge 16 ☐ East ☒ West
(location)

3140 Ft North from Southeast Corner of Section
3140 Ft West from Southeast Corner of Section
(Note: Locate well on Section Plat on reverse side)

Nearest lease or unit boundary line 500' feet.

County Rooks

Lease Name Rogers Well# 1

Domestic well within 330 feet: ☐ yes ☒ no

Municipal well within one mile: ☐ yes ☒ no

Depth to Bottom of fresh water 100 feet

Lowest usable water formation Dakota

Depth to Bottom of usable water 700 feet

Surface pipe by Alternate: 1 ☐ 2 ☒

Surface pipe to be set 200 feet

Conductor pipe if any required feet

Ground surface elevation 2068 feet MSL

This Authorization Expires 10-8-85

Approved By RCH/KCC 4-8-85

Date 4/8/85 Signature of Operator or Agent John W. Sutherland Title GENERAL PARTNER

Form C-1 4/84


MHC/KOHE 4-9-85

Must be filed with the K.C.C. five (5) days prior to commencing well completion. Void if drilling not started within six (6) months of date received by K.C.C.

RECEIVED
STATE CORPORATION COMMISSION

4-9-85
APR 9 1985

A Regular Section of Land
1 Mile = 5,280 Ft.

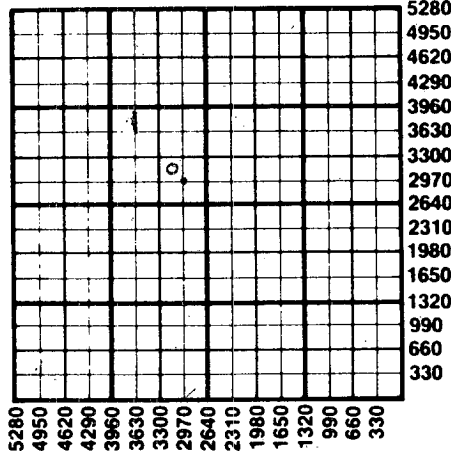

Important procedures to follow:

1. Notify District office before setting surface casing.
2. Set surface casing by circulating cement to the top.
3. File completion forms ACO-1 with K.C.C. within 90 days of well completion, following instructions on ACO-1, side 1, and including copies of wireline logs.
4. Notify District office 48 hours prior to old well workover or re-entry.
5. Prior to plugging, prepare a plugging plan, then obtain agreement from the appropriate district office for an approved plugging plan.
6. Submit plugging report (CP-4) to K.C.C. after plugging is completed.
7. Obtain an approved injection docket number before disposing of salt water.
8. Notify K.C.C. within 10 days when injection commences or terminates.
9. If an alternate 2 completion, cement in the production pipe from below any usable water to surface within 120 days of spud date.

State Corporation Commission of Kansas
Conservation Division
200 Colorado Derby Building
Wichita, Kansas 67202
(316) 263-3238