

CARD MUST BE TYPED

State of Kansas

CARD MUST BE SIGNED

NOTICE OF INTENTION TO DRILL

(see rules on reverse side)

Expected Spud Date..... August 16 1987.....
month day year

API Number 15— 063-21136-00-00

OPERATOR: License # 5181
Name SLAWSON, DONALD C.
Address 200 Douglas Building
City/State/Zip Wichita, Kansas 67202
Contact Person Bill Horigan
Phone (316) 263-3201

SW SW Sec. 23 Twp. 11 S, Rg. 30 East
500' West
4620' Ft. from South Line of Section
Ft. from East Line of Section

(Note: Locate well on Section Plat on reverse side)

CONTRACTOR: License # 5657
Name Slawson Drilling Co.
City/State Great Bend, Kansas

Nearest lease or unit boundary line 500' feet
County Gove
Lease Name MARTIN 'UU' Well # 1

Well Drilled For: Well Class: Type Equipment:
 Oil Storage Infield Mud Rotary
 Gas Inj Pool Ext. Air Rotary
 OWWO Expl Wildcat Cable

Ground surface elevation 2900' GR. (Topo) feet MSL
Domestic well within 330 feet: yes no
Municipal well within one mile: yes no
Depth to bottom of fresh water 180'
Depth to bottom of usable water 1400'
Surface pipe by Alternate: 1 2

If OWWO: old well info as follows:

Surface pipe planned to be set 280'
Conductor pipe required
Projected Total Depth 4650' feet
Formation Mississippian

Operator
Well Name
Comp Date Old Total Depth

I certify that well will comply with K.S.A. 55-101, et seq., plus eventually plugging hole to KCC specifications. Western Kansas
Date 8/7/87 Signature of Operator or Agent Robert B. Jenkins Title District Geologist

For KCC Use:

Conductor Pipe Required feet; Minimum Surface Pipe Required 250 feet per Alt. 1
This Authorization Expires 2-7-88 Approved By DA 8-7-87


Must be filed with the K.C.C. five (5) days prior to commencing well
 This card void if drilling not started within six (6) months of date received by K.C.C.

Important procedures to follow:

1. Notify District office before setting surface casing.
 2. Set surface casing by circulating cement to the top.
 3. File completion forms ACO-1 with K.C.C. within 120 days of well spud date, following instructions on ACO-1, side 1, and including copies of wireline logs.
 4. Notify District office 48 hours prior to old well workover or re-entry.
 5. Prior to filing Intent, prepare a proposed plugging plan in case well is D & A, then obtain approval of plan when calling district office prior to setting surface pipe.
 6. Submit plugging report (CP-4) to K.C.C. after plugging is completed.
 7. Obtain an approved injection docket number before disposing of salt water.
 8. Notify K.C.C. within 10 days when injection commences or terminates.
- Use alternate 2 completion, cement in the production pipe from below any usable water to surface within 120 days of spud date.

A Regular Section of Land

1 Mile = 5,280 Ft.

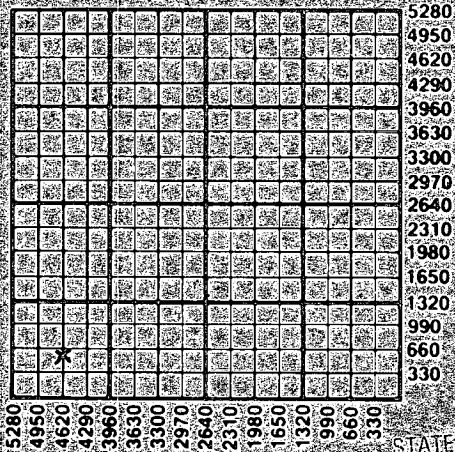

RECEIVED
 STATE CORPORATION COMMISSION

AUG 7 1987
 8-7-1987
 CONSERVATION DIVISION
 Wichita, Kansas

State Corporation Commission of Kansas
 Conservation Division
 200 Colorado Derby Building
 Wichita, Kansas 67202-1212
 (316) 263-3238

15-063-21136-00-00

CARD MUST BE TYPED

State of Kansas

CARD MUST BE SIGNED

NOTICE OF INTENTION TO DRILL

(see rules on reverse side)

Expected Spud Date: August 16 1987

API Number 15-063-21136

OPERATOR: License # 5181
Name SLAWSON, DONALD C.
Address 200 Douglas Building
City/State/Zip Wichita, Kansas 67202
Contact Person Bill Horigan
Phone (316) 263-3201

SW SW Sec. 23 Twp. 11 S, Rg. 30
500' Ft. from South Line of Section
4620' Ft. from East Line of Section

CONTRACTOR: License # 5657
Name Slawson Drilling Co.
City/State Great Bend, Kansas

(Note: Locate well on Section Plat on reverse side)
Nearest lease or unit boundary line 500' feet
County Gove

Well Drilled For: Well Class: Type Equipment:
[X] Oil Storage Infield [X] Mud Rotary
Gas Inj Pool Ext Air Rotary
OWWO Expl [X] Wildcat Cable

Lease Name MARTIN 'UU' Well # 1
Ground surface elevation 2900' GR (Topo) feet MSL
Domestic well within 330 feet: yes no
Municipal well within one mile: yes no
Depth to bottom of fresh water 180'
Depth to bottom of usable water 1400'
Surface pipe by Alternate: 1 2 [X]
Surface pipe planned to be set 280'
Conductor pipe required
Projected Total Depth 4650' feet

If OWWO: old well info as follows:
Operator
Well Name
Comp Date Old Total Depth

Formation Mississippian
I certify that well will comply with K.S.A. 55-101, et seq., plus eventually plugging hole to KCC specifications: Western Kansas
Date 8/7/87 Signature of Operator or Agent Robert B. Jenkins Title District Geologist

For KCC Use:
Conductor Pipe Required feet; Minimum Surface Pipe Required feet per Alt. 1
This Authorization Expires 2-7-88 Approved By DA 8-7-87


Handwritten notes: Row 5 Spud 9.4.87, Date 5 P. 280, 9.5.87, water well

PLUGGING PROPOSAL IF ABOVE IS D. & A.

This plugging proposal will be reviewed and approved or revised at the time the district office is called prior to setting surface casing (call 7 a.m. to 5 p.m. workdays).

Table with 3 columns: Plug depth (ft.), Formation, and Cement/Grout details (e.g., 60/40 Poz. w/6% Gel).

NOTE: Agreement between operator and district office on plug placement and the amount of cement to be used is necessary prior to plugging. In Addition: Call district office before well is either plugged or production casing is cemented in. (Call 7 a.m. to 5 p.m. workdays)

District office use only:
API #15-063-21136
Surface casing of feet set with sxs at hours, 19
Alternate 1 or 2 surface pipe was used.
Alternate 2 cementing was completed @ ft. depth with sxs on 19
Hole plugged 19 agent

RECEIVED
AUG 11 1987
8-11-1987
Hays, KS
SEP 25 1987
9-25-1987
CONSERVATION DIVISION
Wichita, Kansas