

KANSAS CORPORATION COMMISSION
OIL & GAS CONSERVATION DIVISION

Form CP-1
September 2003
Form must be Typed
Form must be Signed
All blanks must be Filled

WELL PLUGGING APPLICATION

Please TYPE Form and File ONE Copy

API # 15- 187-20871-0000 (Identifier Number of this well). This must be listed for wells drilled since 1967; if no API # was issued.

Indicate original spud or completion date 12/10/1995

Well Operator: Presco Western, LLC KCC License #: 32309

Address: 5665 Flatiron Parkway (Owner/Company Name) City: Boulder (Operator's)

State: CO Zip Code: 80301 Contact Phone: 303 305-1163

Lease: Kaylee Brooks Well #: 1-35 Sec. 35 Twp. 29 R. 40 East West

NE - NE Spot Location/QQQQ County Stanton

810 Feet from (in exact footage) North / South (from nearest outside section corner) Line of Section (not Lease Line)

660 Feet from (in exact footage) East / West (from nearest outside section corner) Line of Section (not Lease Line)

Check One: Oil Well Gas Well D&A Cathodic Water Supply Well
 SWD Docket # _____ ENHR Docket # _____ Other _____

Conductor Casing Size: _____ Set at: _____ Cemented with: _____ Sacks

Surface Casing Size: 8-5/8" Set at: 1,788' Cemented with: 870 Sacks

Production Casing Size: 4-1/2" Set at: 5,708' Cemented with: 435 Sacks

List (ALL) Perforations and Bridgeplug Sets: 5,596 - 5,612' Perforations

Elevation: 3,242.56' (G.L. K.B.) T.D. 5,750' PBDT 5,675' Anhydrite Depth _____
(Stone Corral Formation)

Condition of Well: Good Poor Casing Leak Junk in Hole

Proposed Method of Plugging (attach a separate page if additional space is needed): Tag RBP @ 5,500' & dump 25SX cmt. PU, spot 20

SX cmt @ 3,850'. Spot 25SX cmt @ 2,950' (DV tool @ 2,901'). PU, spot 20SX cmt @ 1,815' (8-5/8" csg shoe @ 1,792'

) PU, spot 60SKS cmt @ 600' to surface in 4-1/2" csg. Dump 15SKS down backside of surface csg.

Verbal agreement between Ken Jöhlik of the KCC & Randy Verret of Presco Western on 5/19/2009

Is Well Log attached to this application as required? Yes No Is ACO-1 filed? Yes No

If not explain why? _____

Plugging of this Well will be done in accordance with K.S.A. 55-101 et. seq. and the Rules and Regulations of the State Corporation Commission

List Name of Company Representative authorized to be in charge of plugging operations:

Kevin Newman 620-309-8413, Tony Aton Phone: 620 952-2403

Address: 303 S. Stubbs Rd. City/State Ulysses/KS

Plugging Contractor To be determined KCC License # N/A
(Company Name) (Contractor's)

Address _____ Phone: _____

Proposed Date and Hour of Plugging (if known?): _____

Payment of the Plugging Fee (K.A.R. 82-3-118) will be guaranteed by Operator or Agent

Date: 5/20/2009 Authorized Operator / Agent: Keli Kowalski

(Signature)

Keli Kowalski

KCC WICHITA

RECEIVED
MAY 21 2009

*DUST!
PCT*


CP-1

KAYLEE BROOKS 1-35
15-187-20871

Original → KCC
Wichita

Fax Copy → KCC
Dist 1

(620) 225-8885

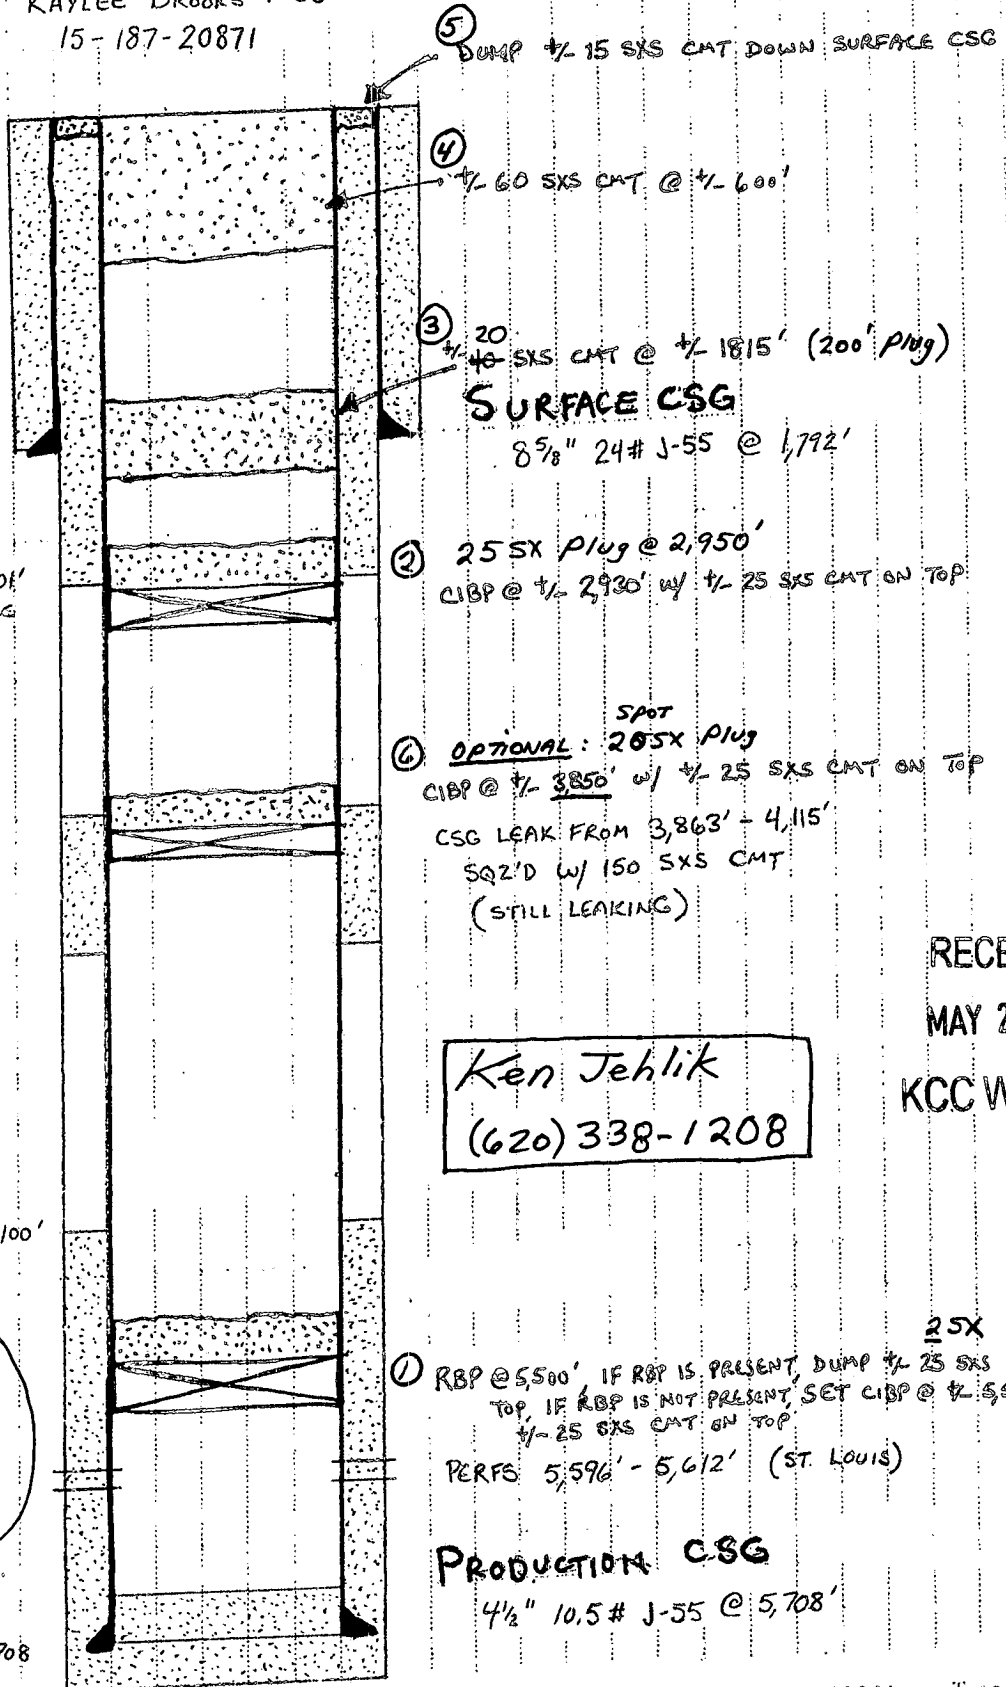

DV Tool @ 2,901'
CMT'D TO SURFACE
w/ 435 SX S

*Will spot cmt.
& not set CIBP's
per original plan
@ 2,930' & 3,850'

Verbal:
Jehlik/Verret
on 5/19/09

Ken Jehlik
(620) 338-1208

RECEIVED
MAY 21 2009
KCC WICHITA

PSTD 5675'

5,708
5,750

PRODUCTION CSG
4 1/2" 10.5# J-55 @ 5,708'



CORPORATION COMMISSION

Mark Parkinson, Governor Thomas E. Wright, Chairman Michael C. Moffet, Commissioner Joseph F. Harkins, Commissioner

NOTICE OF RECEIPT OF WELL PLUGGING APPLICATION (CP-1)

PRESCO WESTERN LLC
5665 FLATIRON PKWY
BOULDER, CO 80301

May 28, 2009

Re: KAYLEE BROOKE #1-35
API 15-187-20871-00-00
35-29S-40W, 4500 FSL 607 FEL
STANTON COUNTY, KANSAS

Dear Operator:

This letter is to notify you that the Conservation Division has received your plugging proposal, form CP-1, for the above well and has reviewed the proposal for completeness. The central office will now forward your CP-1 to the district office listed below for review of the proposed plugging method. **Please contact the district office for approval of your proposed plugging method at least five (5) days before plugging the well, pursuant to K.A.R. 82-3-113(b). If a workover pit will be used during the plugging of the well it must be permitted. A CDP-1 form must be filed and approved prior to the use of the pit in accordance with K.A.R. 82-3-600.**

The Conservation Division's review of form CP-1, either in the central or district office, does not include an inquiry into well ownership or the filing operator's legal right to plug the well. This notice in no way constitutes authorization to plug the above well by persons not having legal rights of ownership or interest in the well.

This notice is void after November 24, 2009. The CP-1 filing does not bring the above well into compliance with K.A.R. 82-3-111 with regard to the Commission's temporary abandonment requirements.

Sincerely,

Steve Bond
Production Department Supervisor

District: #1
210 E Frontview, Suite A
Dodge City, KS 67801
(620) 225-8888