

15-109-20197-00-00

STATE OF KANSAS  
STATE CORPORATION COMMISSION

WELL PLUGGING RECORD

Give All Information Completely  
Make Required Affidavit  
Mail or Deliver Report to  
Conservation Division  
State Corporation Comm.  
245 North Water  
Wichita, KS 67202

Logan County, Sec. 20 Twp. 11S Rge. 32W E/W  
Location as "NE/CNW/SW" or footage from lines  
SE SW SW


Lease Owner Jolley Oil Operations  
Lease Name Porter Well No. #1  
Office Address 39 Professional Plaza, Rexburg, Idaho 83440  
Character of Well (Completed as Oil, Gas or Dry Hole)  
Dry Hole

Date Well completed November 12 1981  
Application for plugging filed November 12 1981  
Application for plugging approved November 12 1981  
Plugging commenced November 12 1981  
Plugging completed November 12 1981  
Reason for abandonment of well or producing formation  
Dry Hole

If a producing well is abandoned, date of last production  
N/A 19

Was permission obtained from the Conservation Division or  
its agents before plugging was commenced? Yes

Name of Conservation Agent who supervised plugging of this well Carl Goodrow  
Producing formation Depth to top Bottom Total Depth of Well 4710'  
Show depth and thickness of all water, oil and gas formations.

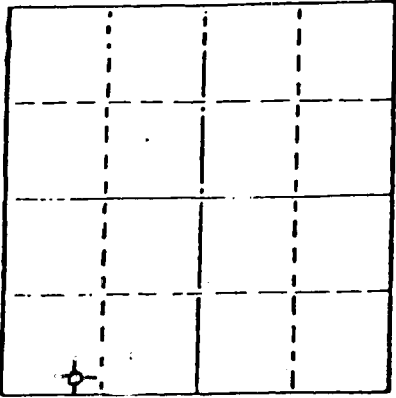

Locate well correctly on above  
Section Plot

OIL, GAS OR WATER RECORDS

CASING RECORD

FORMATION	CONTENT	FROM	TO	SIZE	PUT IN	PULLED OUT
Sand				8 5/8"	297'	none

Describe in detail the manner in which the well was plugged, indicating where the mud fluid  
was placed and the method or methods used in introducing it into the hold. If cement or other  
plugs were used, state the character of same and depth placed, from feet to  
feet for each plug set.

1750' 80 SX  
290' 40 SX  
40' 10 SX  
RH 10 SX

50 - 50 PAZ 6% gel 3% ccl

(If additional description is necessary, use BACK of this sheet)

Name of Plugging Contractor Service Company

STATE OF Kansas COUNTY OF Sedgwick, ss.  
Paul A. Seymour, III (employee of owner) or (owner or operator)  
of the above-described well, being first duly sworn on oath, says: That I have knowledge of  
the facts, statements, and matters herein contained and the log of the above-described well  
as filed and that the same are true and correct. So help me God.

(Signature) Paul A. Seymour III  
Paul A. Seymour, III-Box 8287-Munger Station  
(Address) Wichita, Ks. 67208

SUBSCRIBED AND SWORN TO before me this 18th day of November, 19 81

LaDonna F. Landrum  
Notary Public.

My commission expires August 18, 1984

RECEIVED  
STATE CORPORATION COMMISSION  
LaDonna F. Landrum  
NOTARY PUBLIC  
STATE OF KANSAS  
My Appt. Exp. 11-19-1981  
NOV 19 1981  
CONSERVATION DIVISION  
Wichita, Kansas