


Give All Information Completely
Make Required Affidavit
Mail or Deliver Report to:
Conservation Division
State Corporation Commission
P. O. Box 17027
Wichita, Kansas 67217
NORTH

WELL PLUGGING RECORD

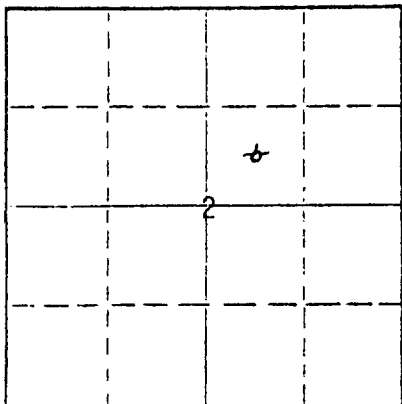

Locate well correctly on above
Section Plat

Logan County, Sec 2 Twp 11S Rge (E) 33W (W)
Location as "NE/CNWxSWx" or footage from lines C SW NE
Lease Owner AGIP PETROLEUM CO., INC. Donald C. Slawson, agent
Lease Name Soucie 'A' Well No. 1
Office Address 200 Douglas Building Wichita, Kansas 67202
Character of Well (completed as Oil, Gas or Dry Hole) Dry Hole
Date well completed April 4, 19 82
Application for plugging filed April 4, 19 82
Application for plugging approved April 4, 19 82
Plugging commenced April 4, 19 82
Plugging completed April 4, 19 82
Reason for abandonment of well or producing formation Dry Hole

If a producing well is abandoned, date of last production 19
Was permission obtained from the Conservation Division or its agents before plugging was commenced? Yes

Name of Conservation Agent who supervised plugging of this well Carl Goodrow
Producing formation Depth to top Bottom Total Depth of Well 4805 Feet
Show depth and thickness of all water, oil and gas formations.

OIL, GAS OR WATER RECORDS

CASING RECORD

FORMATION	CONTENT	FROM	TO	SIZE	PUT IN	PULLED OUT
		surface	389'	8 5/8"		

Describe in detail the manner in which the well was plugged, indicating where the mud fluid was placed and the method or methods used in introducing it into the hole. If cement or other plugs were used, state the character of same and depth placed, from feet to feet for each plug set.

1st plug @ 1475' w/80 sx
2nd plug @ 400' w/40 sx
Bridge @ 40' w/10 sx
10 sx in Rat Hole


6-14-1982
1982

CONSERVATION DIVISION
Wichita, Kansas

(If additional description is necessary, use BACK of this sheet)
Name of Plugging Contractor Halliburton Services
Address Box 579 Great Bend, Kansas 67530

STATE OF KANSAS, COUNTY OF SEDGWICK ss.
William R. Horigan (agent for the operator) of the above-described

well, being first duly sworn on oath, says: That I have knowledge of the facts, statements, and matters herein contained and the log of the above-described well as filed and that the same are true and correct. So help me God.

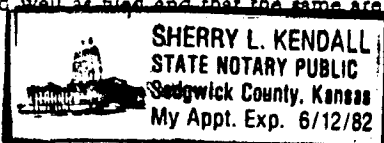

(Signature) William R. Horigan
William R. Horigan 200 Douglas Building

(Address) Wichita, Kansas 67202

SUBSCRIBED AND SWORN TO before me this 18th day of May, 19 82

My commission expires 06/12/82

Sherry L. Kendall
Notary Public.