


WELL PLUGGING RECORD

Give All Information Completely  
Make Required Affidavit  
Mail or Deliver Report to:  
Conservation Division  
State Corporation Commission  
P. O. Box 17027  
Wichita, Kansas 67217  
NORTH

Logan County, Sec. 7 Twp. 11S Rge. (E) 33W (W)  
Location as "NE/CNW/SW" or footage from lines C SW NE  
Lease Owner AGIP PETROLEUM CO., INC. (Donald C. Slawson, agent)  
Lease Name Flipse 'C' Well No. 1  
Office Address 200 Douglas Building Wichita, Kansas 67202  
Character of Well (completed as Oil, Gas or Dry Hole) Dry Hole  
Date well completed April 14, 1982  
Application for plugging filed April 13, 1982  
Application for plugging approved April 13, 1982  
Plugging commenced April 13, 1982  
Plugging completed April 14, 1982  
Reason for abandonment of well or producing formation Dry Hole

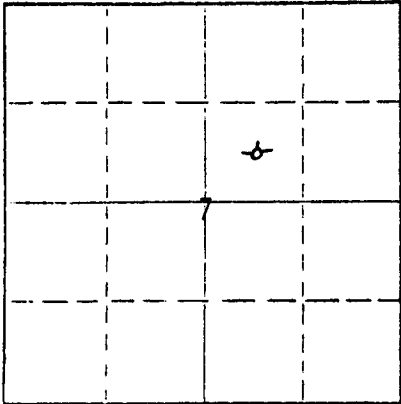

Locate well correctly on above  
Section Plat

If a producing well is abandoned, date of last production 19  
Was permission obtained from the Conservation Division or its agents before plugging was commenced? Yes

Name of Conservation Agent who supervised plugging of this well Carl Goodrow  
Producing formation \_\_\_\_\_ Depth to top \_\_\_\_\_ Bottom \_\_\_\_\_ Total Depth of Well 4807 Feet  
Show depth and thickness of all water, oil and gas formations.

OIL, GAS OR WATER RECORDS

CASING RECORD

FORMATION	CONTENT	FROM	TO	SIZE	PUT IN	PULLED OUT
		surface	585'	8 5/8"		

Describe in detail the manner in which the well was plugged, indicating where the mud fluid was placed and the method or methods used in introducing it into the hole. If cement or other plugs were used, state the character of same and depth placed, from \_\_\_\_\_ feet to \_\_\_\_\_ feet for each plug set.


1st plug @ 1470' w/80 sx  
2nd plug @ 570' w/40 sx  
Top Bridge @ 40' w/10 sx  
10 sx in Rat Hole

6-14-1982

(If additional description is necessary, use BACK of this sheet)  
Name of Plugging Contractor Halliburton Services  
Address Box 579 Great Bend, Kansas 67530

STATE OF KANSAS, COUNTY OF SEDGWICK  
agent for the operator  
William R. Horigan

well, being first duly sworn on oath, says: That I have knowledge of the facts, statements, and matters herein contained and the log of the above-described well as filed and that the same are true and correct. So help me God.

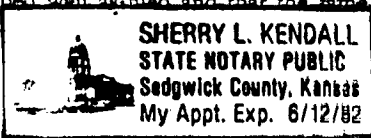

(Signature) William R. Horigan  
William R. Horigan, 200 Douglas Building  
Wichita, Kansas 67202  
(Address)

SUBSCRIBED AND SWORN TO before me this 18th day of May, 1982

My commission expires 06/12/82  
Sherry L. Kendall Notary Public