

STATE OF KANSAS
STATE CORPORATION COMMISSION

WELL PLUGGING RECORD

Give All Information Completely
Make Required Affidavit
Mail or Deliver Report to
Conservation Division
State Corporation Comm.
245 North Water
Wichita, KS 67202

Logan County, Sec. 17 Twp. 11S Rge. 33 SW/W
Location as "NE/CNW SW" or footage from lines

Lease Owner George R. Jones
Lease Name Vogler Well No. #1

Office Address 125 N. Market - Suite 1310, Wichita, Ks.
Character of Well (Completed as Oil, Gas or Dry Hole)

Dry Hole

Date Well completed 10-22-81 19
Application for plugging filed 10-22-81 19
Application for plugging approved 10-22-81 19
Plugging commenced 10-22-81 19
Plugging completed 10-22-81 19


Reason for abandonment of well or producing formation
Commercial quantities of oil not found

If a producing well is abandoned, date of last production 19.

Was permission obtained from the Conservation Division or its agents before plugging was commenced? Yes

Name of Conservation Agent who supervised plugging of this well Gilbert Balthazor
Producing formation Depth to top Bottom Total Depth of Well 4830'

Show depth and thickness of all water, oil and gas formations.

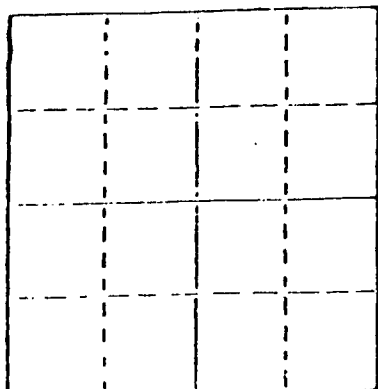

Locate well correctly on above Section Map

OIL, GAS OR WATER RECORDS

CASING RECORD

FORMATION	CONTENT	FROM	TO	SIZE	PUT IN	PULLED OUT
				8 5/8"	250'	None

Describe in detail the manner in which the well was plugged, indicating where the mud fluid was placed and the method or methods used in introducing it into the hold. If cement or other plugs were used, state the character of same and depth placed, from feet to feet for each plug set.

Plug @ 1450' w/70 sx.
Plug @ 240' w/40 sx.
Plug @ 40' w/10 sx.
Rat Hole 10 sx.

11-30-1981

(If additional description is necessary, use BACK of this sheet)

Name of Plugging Contractor Rains & Williamson Oil Co., Inc.

STATE OF Kansas COUNTY OF Sedgwick, ss.
Wilson Rains, President of Rains & Williamson Oil Co., (employee of owner) or (owner or operator) of the above-described well, being first duly sworn on oath, says: That I have knowledge of the facts, statements, and matters herein contained and the log of the above described well as filed and that the same are true and correct. So help me God.

(Signature) Wilson Rains
435 Page Court, 220 W. Douglas, Wichita, Ks. 67202
(Address)

SUBSCRIBED AND SWORN TO before me this 26 day of October, 19 81



Juanita M. Green
Juanita M. Green Notary Public

Countersigned

15-109-20190-00-00

DRILLER'S LOG

COMPANY: George R. Jones

SEC. 17 T. 11S R. 33W

WELL NAME: Vogler #1

LOC. SW SW SW

COUNTY: Logan

RIG NO. #2

TOTAL DEPTH 4830'

ELEVATION

COMMENCED: 10-12-81

COMPLETED: 10-22-81

CONTRACTOR: Rains & Williamson Oil Co., Inc.

CASING RECORD:

SURFACE: 8 5/8" @ 250' w/165 sx. 50/50 poz., 2% gel, 3% cc.

PRODUCTION: D&A

LOG

(Figures Indicate Bottom of Formations)

Shale	2630
Shale & Lime	3250
Lime	3860
Lime & Shale	4160
Lime	4830
<u>ROTARY TOTAL DEPTH</u>	<u>4830</u>

STATE OF Kansas)

COUNTY OF Sedgwick)

SS:


STATE OF KANSAS
11-30-1981

I, Wilson Rains, President of Rains & Williamson Oil Co., Inc.

upon oath state that the above and foregoing is a true and correct copy of the log of the

Vogler #1 well.

Wilson Rains
Wilson Rains

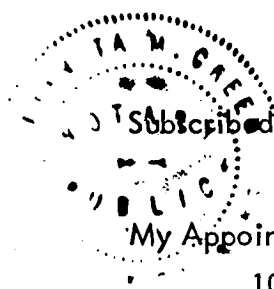

Subscribed and sworn to before me this 26 day of October, 1981.

My Appointment Expires:

10-4-83

Juanita M. Green
Juanita M. Green