


STATE OF KANSAS
STATE CORPORATION COMMISSION

WELL PLUGGING RECORD

Give All Information Completely
Make Required Affidavit
Mail or Deliver Report to:
Conservation Division
State Corporation Commission
800 Biting Building
Wichita, Kansas

Rooks County. Sec. 18 Twp. 10S Rge. (E) 17 (W)
Location as "NE/CNW/SW" or footage from lines SW $\frac{1}{4}$ -SW $\frac{1}{4}$ -SW $\frac{1}{4}$
Lease Owner Champlin Refining Company
Lease Name Adam Garvert Well No. 1
Office Address P.O. Dr. #552, Enid, Oklahoma
Character of Well (completed as Oil, Gas or Dry Hole) Oilwell
Date well completed February 28, 1953
Application for plugging filed June 26, 1953
Application for plugging approved June 29, 1953
Plugging commenced June 29, 1953
Plugging completed July 3, 1953

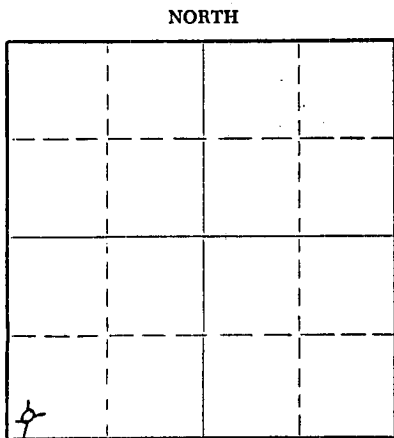

Locate well correctly on above
Section Plat

Reason for abandonment of well or producing formation non profitable to produce

If a producing well is abandoned, date of last production June 12 1953

Was permission obtained from the Conservation Division or its agents before plugging was commenced? Yes

Name of Conservation Agent who supervised plugging of this well Mr. Eldon Petty

Producing formation _____ Depth to top _____ Bottom _____ Total Depth of Well 3756' Feet

Show depth and thickness of all water, oil and gas formations. 3697' P.B.T.D.

OIL, GAS OR WATER RECORDS

CASING RECORD

FORMATION	CONTENT	FROM	TO	SIZE	PUT IN	PULLED OUT
				5 1/2" OD	3754'	2979'

Describe in detail the manner in which the well was plugged, indicating where the mud fluid was placed and the method or methods used in introducing it into the hole. If cement or other plugs were used, state the character of same and depth placed, from _____ feet to _____ feet for each plug set.

Filled hole with sand from 3697' to 3630' and set cement Plug 3630' to 3602' using 4 sacks cement then filled hole with heavy mud from 3602' to 170' set rock bridge from 170' to 160' and cement plug from 160' to 115' using 15 sacks of cement and filled hole with heavy mud from 115' to 35' and set rock bridge from 35' to 30' then sit cement plug in top of well from 30' to bottom of cellar using 10 sacks cement.

(If additional description is necessary, use BACK of this sheet)

Name of Plugging Contractor Pipe Pulling Inc.
Address Stafford, Kansas

STATE OF Kansas, COUNTY OF Barton, ss.
S.P. Hall (employee of owner) or (~~owner~~ operator) of the above-described

well, being first duly sworn on oath, says: That I have knowledge of the facts, statements, and matters herein contained and the log of the above-described well as filed and that the same are true and correct. So help me God.

(Signature) S. P. Hall

P.O. Box 167, Ellinwood, Kansas
(Address)

SUBSCRIBED AND SWORN to before me this 7th day of July, 1953


N. Kenneth Stearns
Notary Public.

My commission expires Sept. 10, 1955

24-2675-S 2-52-20M


STATE OF KANSAS
7-8-53
JUL 8 1953

CONSERVATION DIVISION
Wichita, Kansas

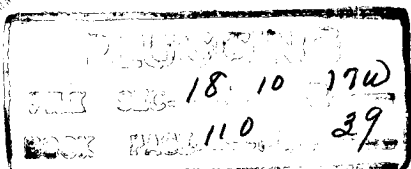

CHAMPLIN REFINING COMPANY
Adam Garvert #1
SW $\frac{1}{4}$ -SW $\frac{1}{4}$ -SW $\frac{1}{4}$
Section 18 T10s R17w
Rooks County, Kansas

0	-	40	Clay & Sand
40	-	70	Shale & Sand
70	-	160	Shale & Sand
160	-	440	Shale & Shells
440	-	810	Shale & Shells
810	-	1170	Sand & Shale
1170	-	1300	Sand Shale
1300	-	1445	Sand, Shale Shells
1445	-	1480	Anhyrite
1480	-	1625	Shale
1625	-	1905	Shale
1905	-	1990	Shale
1990	-	2060	Salt
2060	-	2180	Lime
2180	-	2280	Lime & Shale
2280	-	2345	Lime & shale
2345	-	2445	Lime & shale
2445	-	2555	Lime & shale
2555	-	2575	Lime & shale
2575	-	2590	Shale break
2590	-	2660	Lime & shale
2660	-	2730	Lime
2730	-	2810	Lime & shale
2810	-	2930	Lime & shale
2930	-	3020	Lime broken
3020	-	3180	Lime & shale
3180	-	3660	Lime
3660	-	3695	Shale & Lime
3695	-	3736	Cong.
3736	-	3751	Shale & chat
3751	-	3756	Lime
3756	-		Total Depth

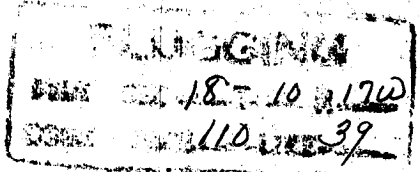

 18-10-120
 110-39