


STATE OF KANSAS  
STATE CORPORATION COMMISSION

WELL PLUGGING RECORD

Give All Information Completely  
Make Required Affidavit  
Mail or Deliver Report to:  
Conservation Division  
State Corporation Commission  
800 Biting Building  
Wichita, Kansas

Rooks County, Sec. 18 Twp. 10S Rge. (E) 17(W)  
Location as "NE/CNW/SW" or footage from lines. NW 1/4 - NW 1/4 - SW 1/4  
Lease Owner Champlin Refining Company  
Lease Name Garvert Well No. 2  
Office Address Dr. #552 Enid, Oklahoma  
Character of Well (completed as Oil, Gas or Dry Hole) Dry Hole  
Date well completed May 17, 19 53  
Application for plugging filed May 20, 19 53  
Application for plugging approved May 17, (Verbal) 19 53  
Plugging commenced May 17, 19 53  
Plugging completed May 17, 19 53  
Reason for abandonment of well or producing formation \_\_\_\_\_

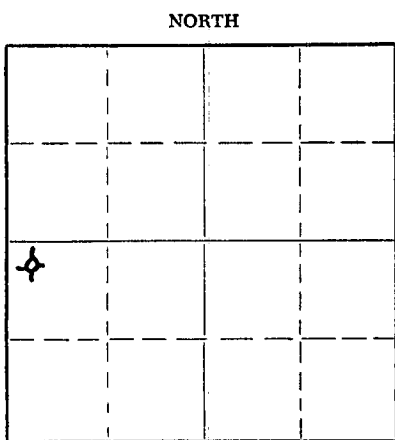

Locate well correctly on above  
Section Plat

If a producing well is abandoned, date of last production \_\_\_\_\_ 19 \_\_\_\_  
Was permission obtained from the Conservation Division or its agents before plugging was commenced? Yes

Name of Conservation Agent who supervised plugging of this well Eldon Petty  
Producing formation \_\_\_\_\_ Depth to top \_\_\_\_\_ Bottom \_\_\_\_\_ Total Depth of Well 3753 Feet  
Show depth and thickness of all water, oil and gas formations.

OIL, GAS OR WATER RECORDS

CASING RECORD

FORMATION	CONTENT	FROM	TO	SIZE	PUT IN	PULLED OUT
				9" OD	147'	None

Describe in detail the manner in which the well was plugged, indicating where the mud fluid was placed and the method or methods used in introducing it into the hole. If cement or other plugs were used, state the character of same and depth placed, from \_\_\_\_\_ feet to \_\_\_\_\_ feet for each plug set.

Filled hole with heavy rotary mud from 3753' T.D. to 145' and set Halliburton plug at 145' and dumped 1/2 sack of hulls and pumped in 15 sacks of cement then filled hole with heavy mud from top of cement to 40' and set Halliburton plug and dumped in 1/2 sack of hulls and 10 sacks of cement filling hole to bottom of cellar.

5-21-53

(If additional description is necessary, use BACK of this sheet)

Name of Plugging Contractor Champlin Refining Company (Rotary Tools)  
Address Dr. #552, Enid, Oklahoma

STATE OF Kansas, COUNTY OF Barton, ss. S. P. Hall (employee of owner) or (owner/operator) of the above-described well, being first duly sworn on oath, says: That I have knowledge of the facts, statements, and matters herein contained and the log of the above-described well as filed and that the same are true and correct. So help me God.

(Signature) S. P. Hall  
Box 167, Ellinwood, Kansas  
(Address)

SUBSCRIBED AND SWORN TO before me this 20th day of May, 19 53

My commission expires Sept. 10, 1955

**PLUGGING**  
FILE SEC 18 T 10 R 17W  
BOOK PAGE 102 LINE 21

CHAMPLIN REFINING COMPANY  
 Garvert #2  
 NW/4 NW/4 SW/4 Sec. 18  
 T10S R17W  
 Rooks County, Kansas

0' - 147' Sand & Shale  
 147' - 760' Sand & Shale  
 760' - 1435' Shale & Sand  
 1435' - 1445' Anhydrite  
 1445' - 1470' Anhydrite  
 1470' - 1740' Red bed Shale & Shells  
 1740' - 2265' Shale & Shells  
 2265' - 2307' Lime  
 2307' - 2405' Shale & Lime  
 2405' - 2684' Lime & Shale  
 2684' - 3141' Shale & Lime  
 3141' - 3218' Lime  
 3218' - 3320' Lime & Shale  
 3320' - 3421' Lime  
 3421' - 3505' Lime & Shale  
 3505' - 3622' Lime  
 3622' - 3645' Lime & Chert  
 3645' - 3660' Conglomerate  
 3660' - 3694' Congl. Shale & Lime  
 3694' - 3735' Shale, Lime & Chert  
 3735' - 3753' Lime & Chert

3753' Total Depth

RECEIVED  
 STATE COMMISSION OF CONSERVATION

MAY 21 1939

CONSERVATION DIVISION  
 Wichita, Kansas

**PLUGGING**

FILE SEC 18 T 10 R 17W  
 BOOK PAGE 102 LINE 21