

STATE OF KANSAS  
STATE CORPORATION COMMISSION


WELL PLUGGING RECORD

Give All Information Completely  
Make Required Affidavit  
Mail or Deliver Report to:  
Conservation Division  
State Corporation Commission  
800 Bittling Building  
Wichita, Kansas

Rocks \_\_\_\_\_ County. Sec. 17 Twp. 10 Rge. 17 ~~25~~ (W)

Location as "NE/CNW $\frac{1}{4}$ SW $\frac{1}{4}$ " or footage from lines SW SW SE  
Lease Owner Graham-Messman-Rinehart Oil Company  
Lease Name Bohning Well No. 1  
Office Address 204 North Market, Wichita, Kansas  
Character of Well (completed as Oil, Gas or Dry Hole) Dry  
Date well completed November 7 19 51  
Application for plugging filed November 21 19 51  
Application for plugging approved November 9 19 51  
Plugging commenced November 9 19 51  
Plugging completed November 16 19 51  
Reason for abandonment of well or producing formation Dry Hole

NORTH

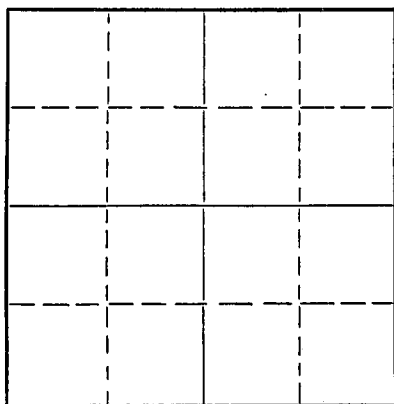

Locate well correctly on above Section Plat

If a producing well is abandoned, date of last production 19  
Was permission obtained from the Conservation Division or its agents before plugging was commenced? Yes

Name of Conservation Agent who supervised plugging of this well Eldon Petty  
Producing formation \_\_\_\_\_ Depth to top \_\_\_\_\_ Bottom \_\_\_\_\_ Total Depth of Well 3725 Feet  
Show depth and thickness of all water, oil and gas formations.

OIL, GAS OR WATER RECORDS

CASING RECORD

Formation	Content	From	To	Size	Put In	Pulled Out
				8 5/8"	220'	None

Describe in detail the manner in which the well was plugged, indicating where the mud fluid was placed and the method or methods used in introducing it into the hole. If cement or other plugs were used, state the character of same and depth placed, from \_\_\_\_\_ feet to \_\_\_\_\_ feet for each plug set.

Mud to 200' - rock plug @ 200', 15 sx cement; mud to 40', rock plug with 10 sx cement - mud to surface

(If additional description is necessary, use BACK of this sheet)

Name of Plugging Contractor Graham-Messman-Rinehart Oil Company  
Address 204 North Market, Wichita, Kansas


STATE OF Kansas, COUNTY OF Sedgwick, ss.  
J. A. Gilliland (employee of owner) or (owner or operator) of the above-described well,  
being first duly sworn on oath, says: That I have knowledge of the facts, statements, and matters herein contained and the log of the above-described well as filed and that the same are true and correct. So help me God.

(Signature) *J. A. Gilliland*

204 North Market, Wichita, Kansas  
STATE CORPORATION COMMISSION (Address)

NOV 23 1951  
11-23-51  
CONSERVATION DIVISION  
Wichita, Kansas

*Oliver Carter*  
Notary Public.

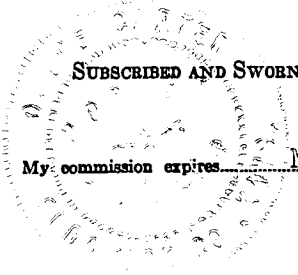

SUBSCRIBED AND SWORN to before me this 21 day of November, 19 51  
My commission expires March 21, 1955

PLUGGING  
FILE SEC 1710 R270  
BOOK PAGE 194 LIST 1

BOHNING #1

WELL RECORD

Location: SW SW SE 17-10S-17W  
 Rooks County, Kansas  
 Operator: Graham-Messman-Rinehart Oil Co.  
 204 North Market  
 Wichita, Kansas  
 Casing Record: 8 5/8" @ 220' w/150 sx.

Commenced: October 30, 1951  
 Completed: November 7, 1951  
 Elevation: 2096 R. B.  
 Production: Dry Hole  
 Contractor: Lohmann-Johnson Drlg. Co., Inc.

LOG

(Figures indicate bottom of formation)

Sand & clay 40  
 Shale 220  
 Shale & sand 400  
 Shale & shells 556  
 Shale & shells 765  
 Sand & shale 1060  
 Shale & red bed 1220  
 Shale 1378  
 Lime 1415  
 Shale & shells 1433  
 Shale & shells 1524  
 Shale & shells 1900  
 Shale & shells 2075  
 Lime & shale 2180  
 Lime 2305  
 Lime 2380  
 Lime & shale 2435  
 Lime & shale 2590  
 Lime & shale 2730  
 Lime & shale 2888  
 Lime & shale 2930  
 Lime 2985  
 Lime & shale 3094  
 Lime & shale 3134  
 Lime & shale 3193  
 Lime & shale 3235  
 Lime 3273  
 Lime & shale 3321  
 Lime & shale 3350  
 Lime 3360  
 Lime 3397  
 Lime & shale 3446  
 Lime 3472  
 Lime 3491  
 Lime & shale 3541  
 Lime & shale 3581  
 Lime & chert 3605  
 Chert 3630  
 Lime & shale 3664  
 Lime & shale 3686  
 Lime & shale 3725

T O P S

Topeka 3050 (-954)  
 Heebner 3275  
 Toronto 3301  
 Lansing 3317 (-1221)  
 Cherty Cong. 3585 (-1489)  
 Simpson 3652 (-1556)  
 Arbuckle 3704 (-1608)

The undersigned, Graham-Messman-Rinehart Oil Company, hereby certifies that the above log is a true and correct log of the formation encountered in drilling the above well as reflected by the Daily Drilling Reports.

**PLUGGING**  
 FILE SEC 17 T 10 R 17W  
 BOOK 24 PAGE 1

GRAHAM-MESSMAN-RINEHART OIL COMPANY  
 By J. A. Gilliland  
 J. A. Gilliland

Subscribed and sworn to before me  
 this 20th day of November, 1951

Oliver Carter  
 Notary Public

My commission expires: March 21, 1955.