

CARD MUST BE TYPED

State of Kansas
NOTICE OF INTENTION TO DRILL

CARD MUST BE SIGNED

(see rules on reverse side)

Starting Date: 11 09 84
month day year

API Number 15- 195- 21, 631-00-00

OPERATOR: License # 9067
Name DaMar Resources, Inc.
Address P. O. Box 70
City/State/Zip Hays, KS 67601
Contact Person Daniel F. Schippers
Phone (913) 625-0020

165' E NE NW SE Sec 34 Twp 11 S, Rge 24
(location) East West

2310 Ft North from Southeast Corner of Section
1485 Ft West from Southeast Corner of Section
(Note: Locate well on Section Plat on reverse side)

CONTRACTOR: License # 5381
Name Big Springs Drilling
City/State Wichita, KS 67208

Nearest lease or unit boundary line 330 feet
County Trego
Lease Name Struss Well# 1

Domestic well within 330 feet: yes no
Municipal well within one mile: yes no

Well Drilled For: Well Class: Type Equipment:
 Oil Swd Infield Mud Rotary
 Gas Inj Pool Ext. Air Rotary
 OWWO Expl Wildcat Cable

Depth to Bottom of fresh water 120 feet
Lowest usable water formation Dakota
Depth to Bottom of usable water 1000 1000 feet
Surface pipe by Alternate: 1 2
Surface pipe to be set 240 feet
Conductor pipe if any required none feet
Ground surface elevation 2472 feet MSI
This Authorization Expires 5-7-85
Approved By 11-7-84

If OWWO: old well info as follows:

Operator
Well Name
Comp Date Old Total Depth
Projected Total Depth 4150 feet
Projected Formation at TD Lansing
Expected Producing Formations Lansing

I certify that we will comply with K.S.A. 55-101, et seq., plus eventually plugging hole to K.C.C. specifications.


Date 11/05/84 Signature of Operator or Agent Daniel F. Schippers Title President

MHC/WOHE 11/7/84

Must be filed with the K.C.C. five (5) days prior to commencing well
This card void if drilling not started within six (6) months of date received by K.C.C.

Important procedures to follow :

**A Regular Section of Land
1 Mile = 5,280 Ft.**

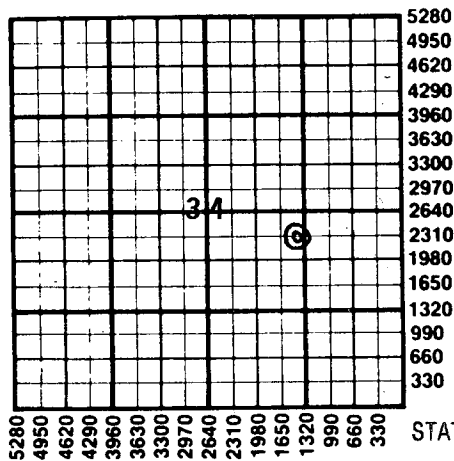

1. Notify District office before setting surface casing.
2. Set surface casing by circulating cement to the top.
3. File completion forms ACO-1 with K.C.C. within 90 days of well completion, following instructions on ACO-1, side 1, and including copies of wireline logs.
4. Notify District office 48 hours prior to old well workover or re-entry.
5. Prior to plugging, prepare a plugging plan, then obtain agreement from the appropriate district office for an approved plugging plan.
6. Submit plugging report (CP-4) to K.C.C. after plugging is completed.
7. Obtain an approved injection docket number before disposing of salt water.
8. Notify K.C.C. within 10 days when injection commences or terminates.
9. If an alternate 2 completion, cement in the production pipe from below any usable water to surface within 120 days of spud date.

RECEIVED

STATE CORPORATION COMMISSION

State Corporation Commission of Kansas

Conservation Division

200 Colorado Derby Building

Wichita, Kansas 67202

(316) 263-3238

NOV 07 1984
11-7-1984

CONSERVATION DIVISION

Wichita, Kansas