

This form shall be filed in duplicate with the Kansas Corporation Commission, 200 Colorado Derby Building, Wichita, Kansas 67202, within ten days after the completion of the well, regardless of how the well was completed.

Attach separate letter of request if the information is to be held confidential. If confidential, only file one copy. Information on side one will be of public record and side two will then be held confidential.

Circle one: Oil, Gas, Dry SWD, OWWO, Injection. Type and complete ALL sections. Applications must be filed for dual completion, commingling, SWD and injection, T.A.

Attach wireline logs (i.e. electrical log, sonic log, gamma ray neutron log, etc.). KCC # (316) 263-3238. (Rules 82-2-105 & 82-2-125) - arriving in separate package

OPERATOR Oxford Exploration Company

API NO. 15-195-21,070-00-00

ADDRESS 1550 Denver Club Building
Denver, CO 80202

COUNTY Trego

FIELD Voda

**CONTACT PERSON David E. Park

PROD. FORMATION Lansing

PHONE (303)572-3821

LEASE Malinowsky

PURCHASER none

WELL NO. 33-2

ADDRESS

WELL LOCATION 33-11s-24w

DRILLING Murfin Drilling Company

550' Ft. from North Line and

CONTRACTOR

2090' Ft. from East Line of

ADDRESS 617 Union Center

the 33 SEC. 11s TWP. 24w RGE.


Wichita, KS 67202

PLUGGING Murfin Drilling Company

WELL FLAT

CONTRACTOR

ADDRESS same as above

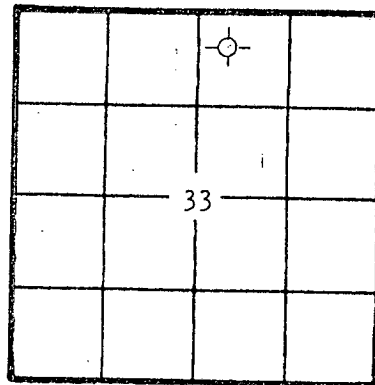

KCC
KGS
(Office Use)

TOTAL DEPTH 4160' PBSD

SPUD DATE 8-19-82 DATE COMPLETED 8-25-82

ELEV: GR 2516' DF KB 2521'

DRILLED WITH (CABLE) (ROTARY) (AIR) TOOLS

Amount of surface pipe set and cemented 219' DV Tool Used? No

AFFIDAVIT

STATE OF Colorado, COUNTY OF Denver, SS, I,

David E. Park OF LAWFUL AGE, BEING FIRST DULY SWORN UPON HIS OATH,

DEPOSES THAT HE IS President (FOR)(OF) Oxford Exploration Company

OPERATOR OF THE Malinowsky LEASE, AND IS DULY AUTHORIZED TO MAKE

THIS AFFIDAVIT FOR AND ON THE BEHALF OF SAID OPERATOR, THAT WELL NO. 33-2 ON

SAID LEASE HAS BEEN COMPLETED AS OF THE 25th DAY OF August, 1982, AND THAT

ALL INFORMATION ENTERED HEREIN WITH RESPECT TO SAID WELL IS TRUE AND CORRECT.

FURTHER AFFIDAVIT IS NOT.

RECEIVED
STATE CORPORATION COMMISSION
SEP 29 1982
9-2-1982
CONSERVATION DIVISION
Wichita, Kansas

(s) David E. Park, Jr. President
August 19 82

SUBSCRIBED AND SWORN BEFORE ME THIS 26th DAY OF

B.B. Taylor
NOTARY PUBLIC B.B. Taylor
1550 Denver Club Bldg
Denver, CO 80202

MY COMMISSION EXPIRES: 1/29/86

**The person who can be reached by phone regarding any questions concerning this information. Within 45 days of completion, a witnessed initial test by the Commission is required if the well produces more than 25 BOPD or is located in a Basic Order Pool.

SIDE TWO

WELL LOG

Show all important zones of porosity and contents thereof; cored intervals, and all drill-stem tests, including depth interval tested, cushion used, time tool open, flowing and shut-in pressures, and recoveries.

SHOW GEOLOGICAL MARKERS, LOGS RUN, OR OTHER DESCRIPTIVE INFORMATION.

FORMATION DESCRIPTION, CONTENTS, ETC.	TOP	BOTTOM	NAME	DEPTH
DST #1 (4046-4060) 15-30-20-40 ISIP 10, FSIP 10 IF 10-10, FF 10-10 IHP 2110, FHP 2110, Rec. 5' Mud. NS			Heebner Toronto LKC B/KC	3852 3874 3889 4126
DST #2 (4060-4084) 15-30-20-40 ISIP 58, FSIP 38 IF 38-38, FF 38-38 IHP 2212, FHP 2174, Rec. 5' Mud. NS				

RELEASED
9-1-1983
SEP 01 1983
FROM CONFIDENTIAL

Report of all strings set — surface, intermediate, production, etc. CASING RECORD (New) or (Used)

Purpose of string	Size hole drilled	Size casing set (in O.D.)	Weight lbs/ft.	Setting depth	Type cement	Sacks	Type and percent additives
Surface	12 1/4"	8 5/8"	20#	219'	common	180	none

LINER RECORD

PERFORATION RECORD

Top, ft.	Bottom, ft.	Sacks cement	Shots per ft.	Size & type	Depth interval

TUBING RECORD

Size	Setting depth	Packer set at

ACID, FRACTURE, SHOT, CEMENT SQUEEZE RECORD

Amount and kind of material used	Depth interval treated

Date of first production	Producing method (flowing, pumping, gas lift, etc.)	Gravity

RATE OF PRODUCTION PER 24 HOURS	Oil bbls.	Gas MCF	Water %	Gas-oil ratio bbls.	CFPB

Disposition of gas (vented, used on lease or sold) Perforations