

15-195-21631-00-00

STATE CORPORATION COMMISSION OF KANSAS  
OIL & GAS CONSERVATION DIVISION

WELL COMPLETION OR RECOMPLETION FORM  
ACO-1 WELL HISTORY

165'

DESCRIPTION OF WELL AND LEASE

Operator: License # 9067  
Name Damar Resources, Inc.  
Address P. O. Box 70  
City/State/Zip Hays, Kansas 67601

Purchaser

Operator Contact Person Daniel F. Schippers  
Phone (913) 625-0020

Contractor: License # 5381  
Name Big Springs Drilling, Inc.

Wellsite Geologist Jerry Green  
Phone (913) 625-5155

Designate Type of Completion  
 New Well  Re-Entry  Workover

Oil  SWD  Temp Abd  
 Gas  Inj  Delayed Comp.  
 Dry  Other (Core, Water Supply etc.)

If OWWO: old well info as follows:  
Operator  
Well Name  
Comp. Date Old Total Depth

WELL HISTORY

Drilling Method:  
 Mud Rotary  Air Rotary  Cable

11-9-84 11-14-84  
Spud Date Date Reached TD Completion Date  
4150'  
Total Depth PBTD

Amount of Surface Pipe Set and Cemented at 259' feet  
Multiple Stage Cementing Collar Used?  Yes  No  
If yes, show depth set feet  
If alternate 2 completion, cement circulated from feet depth to w/SX cmt

API NO. 15- 195 - 21,631 - 00 - 00  
County Trego  
E NE NW SE 34 11S 24W  East  
Sec Twp Rge  West

2310 Ft North from Southeast Corner of Section  
1485 Ft West from Southeast Corner of Section  
(Note: Locate well in section plat below)


Lease Name Struss Well # 1

Field Name

Producing Formation

Elevation: Ground 2472' KB 2477'

Section Plat

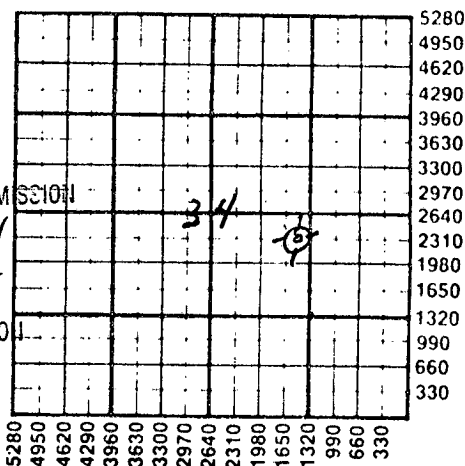

RECEIVED  
11-28-1984  
NOV 28 1984  
STATE CORPORATION COMMISSION  
CONSERVATION DIVISION  
Wichita, Kansas

WATER SUPPLY INFORMATION

Disposition of Produced Water:  Disposal  
Docket #  Repressuring

Questions on this portion of the ACO-1 call:  
Water Resources Board (913) 296-3717

Source of Water: Hauled  
Division of Water Resources Permit #

Groundwater Ft North from Southeast Corner (Well) Ft West from Southeast Corner of Sec Twp Rge  East  West  
 Surface Water 660 Ft North from Southeast Corner (Stream, pond etc) 990 Ft West from Southeast Corner SE/4 Sec 3 Twp 12 Rge 24  East  West  
 Other (explain) (purchased from city, R.W.D. #)


INSTRUCTIONS: This form shall be completed in duplicate and filed with the Kansas Corporation Commission, 200 Colorado Derby Building, Wichita, Kansas 67202, within 90 days after completion or recompletion of any well. Rule 82-3-130 and 82-3-107 apply.  
Information on side two of this form will be held confidential for a period of 12 months if requested in writing and submitted with the form. See rule 82-3-107 for confidentiality in excess of 12 months.  
One copy of all wireline logs and drillers time log shall be attached with this form. Submit CP-4 form with all plugged wells. Submit CP-111 form with all temporarily abandoned wells.

All requirements of the statutes, rules and regulations promulgated to regulate the oil and gas industry have been fully complied with and the statements herein are complete and correct to the best of my knowledge.

Signature Daniel F. Schippers  
Title President Date 11/27/84

Subscribed and sworn to before me this 27th day of November 1984  
Notary Public Darlene Pearson

Date Commission Expires

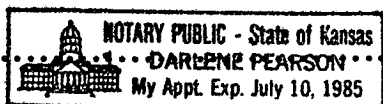

K.C.C. OFFICE USE ONLY  
F  Letter of Confidentiality Attached  
C  Wireline Log Received  
C  Drillers Timelog Received  
Distribution  
 KCC  SWD/Rep  NGPA  
 KGS  Plug  Other (Specify)

Sec 34 Twp 11 Rge 24 W

Operator Name Damar Resources, Inc. Lease Name Struss Well # 1

Sec. 34 Twp. 11S Rge. 24W  East  West County Trego

WELL LOG

INSTRUCTIONS: Show important tops and base of formations penetrated. Detail all cores. Report all drill stem tests giving interval tested, time tool open and closed, flowing and shut-in pressures, whether shut-in pressure reached static level, hydrostatic pressures, bottom hole temperature, fluid recovery, and flow rates if gas to surface during test. Attach extra sheet if more space is needed. Attach copy of log.

Drill Stem Tests Taken  Yes  No  
 Samples Sent to Geological Survey  Yes  No  
 Cores Taken  Yes  No

Formation Description  
 Log  Sample

Name	Top	Bottom
Topeka	3586	(-1109)
Heebner	3818	(-1341)
Toronto	3839	(-1362)
Lansing-K.C.	3853	(-1374)
Lansing-K.C. Base	4100	(-1623)
R.T.D.	4150	(-1673)
L.T.D.	4153	(-1676)

DST #1: 4002-27 (H Bench)  
 30-30-30-30  
 IBHP: 87, FBHP: 60, FP: 46-50 50-50  
 I-Hyd: 2250, F-Hyd: 2221  
 Recovery: 10' mud with a few oil spots

CASING RECORD <input checked="" type="checkbox"/> New <input type="checkbox"/> Used							
Report all strings set-conductor, surface, intermediate, production, etc.							
Purpose of String	Size Hole Drilled	Size Casing Set (in O.D.)	Weight Lbs/Ft.	Setting Depth	Type of Cement	#Sacks Used	Type and Percent Additives
Surface	12 1/4"	8 5/8"	20#	259'	Common	160	2% gel 3%cc
PERFORATION RECORD				Acid, Fracture, Shot, Cement Squeeze Record			
Shots Per Foot	Specify Footage of Each Interval Perforated			(Amount and Kind of Material Used)		Depth	
TUBING RECORD				Liner Run <input type="checkbox"/> Yes <input type="checkbox"/> No			
Date of First Production	Producing Method <input type="checkbox"/> Flowing <input type="checkbox"/> Pumping <input type="checkbox"/> Gas Lift <input type="checkbox"/> Other (explain).....						
Estimated Production Per 24 Hours	Oil	Gas	Water	Gas-Oil Ratio	Gravity		
	Bbls	MCF	Bbls	CFPB			

METHOD OF COMPLETION

Production Interval

Disposition of gas:  Vented  Open Hole  Perforation  
 Sold  Other (Specify) .....  
 Used on Lease  Dually Completed  
 Commingled