

CARD MUST BE TYPED

State of Kansas

CARD MUST BE SIGNED

15-109-20448-00-00

NOTICE OF INTENTION TO DRILL

(see rules on reverse side)

Starting Date September 29, 1987 month day year

API Number 15-109-20,448-00-00 East

OPERATOR: License # 06113

SE NE NW Sec. 18 Twp. 11 S, Rg. 32 X West

Name Landmark Oil Exploration, Inc.

4290 Ft. from South Line of Section

Address 110 S. Main, #510

2970 Ft. from East Line of Section

City/State/Zip Wichita, KS 67202

(Note: Locate well on Section Plat on reverse side)

Contact Person Jeff Wood

Nearest lease or unit boundary line 990.330 feet

Phone 316/265-8181

County Logan

CONTRACTOR: License # 5147

Lease Name Zerr Well # 1-18

Name Beredco, Inc

Ground surface elevation 3056 feet MSL

City/State Wichita, KS

Domestic well within 330 feet: yes X no

Well Drilled For: Well Class: Type Equipment:

Municipal well within one mile: yes X no

X Oil SWD Infield X Mud Rotary

Depth to bottom of fresh water 200'

Gas Inj X Pool Ext Air Rotary

Depth to bottom of usable water 1700'

OWWO X Expl Wildcat Cable

Surface pipe by Alternate 1 2 X

If OWWO: old well info as follows:

Surface pipe planned to be set 250'

Operator

Conductor pipe required

Well Name

Projected Total Depth 4650 feet

Comp Date Old Total Depth

Formation Mississippi

I certify that well will comply with K.S.A. 55-101, et seq., plus eventually plugging hole to KCC specifications.

Date 9-25-87 Signature of Operator or Agent Robert Chitt Title GEOLOGIST

For KCC Use:

Conductor Pipe Required feet; Minimum Surface Pipe Required 250 feet per Alt. X 2


This Authorization Expires 3-25-88 Effective Date 9-30-87 Approved By P.H. 9-25-87

Must be filed with the K.C.C. five (5) days prior to commencing well  
This card void if drilling not started within six (6) months of date received by K.C.C.

### Important procedures to follow:

1. Notify District office before setting surface casing.
2. Set surface casing by circulating cement to the top.
3. File completion forms ACO-1 with K.C.C. within 90 days of well completion, following instructions on ACO-1, side 1, and including copies of wireline logs.
4. Notify District office 48 hours prior to old well workover or re-entry.
5. Prior to filing Intent, prepare a proposed plugging plan in case well is D & A, then obtain approval of plan when calling district office prior to setting surface pipe.
6. Submit plugging report (CP-4) to K.C.C. after plugging is completed.
7. Obtain an approved injection docket number before disposing of salt water.
8. Notify K.C.C. within 10 days when injection commences or terminates.
9. If an alternate 2 completion, cement in the production pipe from below any usable water to surface within 120 days of spud date.

### A Regular Section of Land 1 Mile = 5,280 Ft.

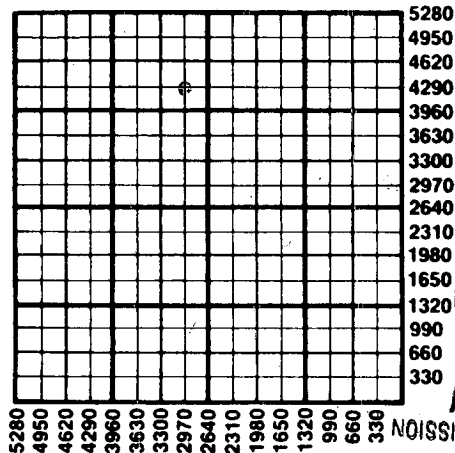

RECEIVED  
STATE CORPORATION COMMISSION  
9-25-1987  
Step 25-1987  
Wichita, Kansas  
CONSERVATION DIVISION

State Corporation Commission of Kansas  
Conservation Division  
200 Colorado Derby Building  
Wichita, Kansas 67202  
(316) 263-3238