

CARD MUST BE TYPED

State of Kansas

CARD MUST BE SIGNED

NOTICE OF INTENTION TO DRILL

15-109-20441-00-00

(see rules on reverse side)

Expected Spud Date June 1, 1987 month day year

API Number 15-109-20,441-00-00

OPERATOR: License # 4656 Name Davis Petroleum, Inc. Address Route 1, Box 183-B City/State/Zip Great Bend, KS 67530 Contact Person L. D. Davis Phone 316-793-3051

NE NE NE Sec. 2 Twp. 11 S, Rg. 33 East West 4950 Ft. from South Line of Section 330 Ft. from East Line of Section

(Note: Locate well on Section Plat on reverse side)

Nearest lease or unit boundary line 330 feet County Logan

CONTRACTOR: License # 5420 Name White & Ellis Drilling, Inc. City/State Wichita, KS

Lease Name Soucie Well # 1 Ground surface elevation 3110 (estimate) feet MSL

Well Drilled For: Well Class: Type Equipment: X Oil Storage Infield X Mud Rotary Gas Inj Pool Ext Air Rotary OWWO Expl Wildcat Cable

Domestic well within 330 feet: yes X no Municipal well within one mile: yes X no

Depth to bottom of fresh water 1650-250 Depth to bottom of usable water 120-250 1750

Surface pipe by Alternate: 1 2 X Surface pipe planned to be set 300

If OWWO: old well info as follows:

Operator Well Name Comp Date Old Total Depth

Conductor pipe required Projected Total Depth 4700 feet Formation Miss

I certify that well will comply with K.S.A. 55-101, et seq., plus eventually plugging hole to KCC specifications.

Date 5-1-87 Signature of Operator or Agent J. M. Vess Title

For KCC Use:


Conductor Pipe Required feet; Minimum Surface Pipe Required 300 feet per Alt. 40

This Authorization Expires 11-4-87 Approved By 5-4-87

Handwritten signatures and initials at the bottom right of the page.

Must be filed with the K.C.C. five (5) days prior to commencing well
This card void if drilling not started within six (6) months of date received by K.C.C.

A Regular Section of Land
1 Mile = 5,280 Ft.

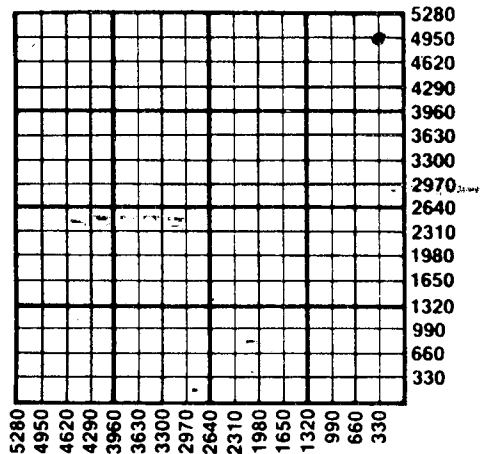

Important procedures to follow:

1. Notify District office before setting surface casing.
2. Set surface casing by circulating cement to the top.
3. File completion forms ACO-1 with K.C.C. within 120 days of well spud date, following instructions on ACO-1, side 1, and including copies of wireline logs.
4. Notify District office 48 hours prior to old well workover or re-entry.
5. Prior to filing Intent, prepare a proposed plugging plan in case well is D & A, then obtain approval of plan when calling district office prior to setting surface pipe.
6. Submit plugging report (CP-4) to K.C.C. after plugging is completed.
7. Obtain an approved injection docket number before disposing of salt water.
8. Notify K.C.C. within 10 days when injection commences or terminates.
9. If an alternate 2 completion, cement in the production pipe from below any usable water to surface within 120 days of spud date.

State Corporation Commission of Kansas
Conservation Division
200 Colorado Derby Building
Wichita, Kansas 67202-1212
(316) 263-3238