

CARD MUST BE TYPED

State of Kansas
NOTICE OF INTENTION TO DRILL
 (see rules on reverse side)

CARD MUST BE SIGNED

Starting Date: November 20 1985
 month day year

API Number 15- 051-24,354-0000

OPERATOR: License # 6772
 Name V. Francis Weigel
 Address Box 244
 City/State/Zip Gorham, Ks. 67640
 Contact Person V. Francis Weigel
 Phone (913) 637-5383

..... SE. NE. SW Sec 1... Twp 11. S, Rge 16 ☐ East
 (location) ☒ West

..... 1705..... Ft North from Southeast Corner of Section
 2970..... Ft West from Southeast Corner of Section
 (Note: Locate well on Section Plat on reverse side)

CONTRACTOR: License # 5655
 Name Shields Drilling Co., Inc.
 City/State Russell, Ks. 67665

Nearest lease or unit boundary line 330 feet.
 County Ellis
 Lease Name Bowlby Well# 6
 Domestic well within 330 feet: ☐ yes ☒ no
 Municipal well within one mile: ☐ yes ☒ no

Well Drilled For:	Well Class:	Type Equipment:
<input checked="" type="checkbox"/> Oil	<input type="checkbox"/> Swd	<input checked="" type="checkbox"/> Mud Rotary
<input type="checkbox"/> Gas	<input type="checkbox"/> Inj	<input type="checkbox"/> Air Rotary
<input type="checkbox"/> OWWO	<input type="checkbox"/> Expl	<input type="checkbox"/> Cable
	<input checked="" type="checkbox"/> Pool Ext.	
	<input type="checkbox"/> Wildcat	

If OWWO: old well info as follows:

Operator
 Well Name
 Comp Date Old Total Depth
 Projected Total Depth feet
 Projected Formation at TD
 Expected Producing Formations

Depth to Bottom of fresh water 100 feet
 Lowest usable water formation Dakota
 Depth to Bottom of usable water ~~100~~ 750 feet
 Surface pipe by Alternate: 1 ☒ 2 ☐
 Surface pipe to be set 800 feet
 Conductor pipe if any required None feet
 Ground surface elevation Est. 1965 feet MSL
 This Authorization Expires 5-12-86
 Approved By 11-12-85

I certify that we will comply with K.S.A. 55-101, et seq., plus eventually plugging hole to K.C.C. specifications.


Date 11-8-85 Signature of Operator or Agent *V. Francis Weigel* Title

Owner

Must be filed with the K.C.C. five (5) days prior to commencing well
This card void if drilling not started within six (6) months of date received by K.C.C.

Important procedures to follow :

A Regular Section of Land
1 Mile = 5,280 Ft.

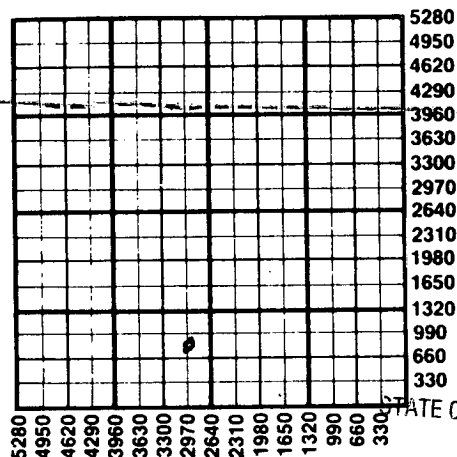

1. Notify District office before setting surface casing.
2. Set surface casing by circulating cement to the top.
3. File completion forms ACO-1 with K.C.C. within 90 days of well completion, following instructions on ACO-1, side 1, and including copies of wireline logs.
4. Notify District office 48 hours prior to old well workover or re-entry.
5. Prior to plugging, prepare a plugging plan, then obtain agreement from the appropriate district office for an approved plugging plan.
6. Submit plugging report (CP-4) to K.C.C. after plugging is completed.
7. Obtain an approved injection docket number before disposing of salt water.
8. Notify K.C.C. within 10 days when injection commences or terminates.
9. If an alternate 2 completion, cement in the production pipe from below any usable water to surface within 120 days of spud date.

RECEIVED

11-12-85

NOV 12 1985

CONSERVATION DIVISION
Wichita, Kansas

State Corporation Commission of Kansas
Conservation Division
200 Colorado Derby Building
Wichita, Kansas 67202
(316) 263-3238