
KANSAS CORPORATION COMMISSION OIL & GAS CONSERVATION DIVISION

WELL PLUGGING APPLICATION

Please TYPE Form and File ONE Copy

Form CP-1 September 2003 This Form must be Typed Form must be Signed All blanks must be Filled

API # 15 - 063-21328 - 000	(Identifier Number of this well).	This must be listed for wells drilled since 1967; if i	no API # was issued,
indicate original spud or completion date 5/8/90	·		
Well Operator: FALCON EXPLORATION INC.		KCC License #: 5316	
(Owner (Company Name)		City: WICHITA (Operator's)	
		Contact Phone: (316) 262 - 1378	3
Lease: BROOKOVER	Well #:_5	Sec. 22 Twp. 13 S. R. 30	_ East West
NW - SW - SEsp	ot Location / QQQQ County	GOVE	
Feet (in exact footage) From 2310 Feet (in exact footage) From Check One: Oil Well Gas Well SWD Docket #	East / West (from neares	st outside section corner) Line of Section (Not Lease st outside section corner) Line of Section (Not Lease Nater Supply Well	Line)
Conductor Casing Size:	Set at:	Cemented with:	Sacks
Surface Casing Size: 8-5/8			
Production Casing Size: 5-1/2			
List (ALL) Perforations and Bridgeplug Sets: 4317-	PBTD: 4428 Anh	ydrite Depth: 2304 (+581) (Stone Corral Formation k in Hole KCC INSTRUCTIONS	ויי
Is Well Log attached to this application as required? If not explain why?	✓ Yes No Is ACO-1 filed?	MA MA	PRPORATION COMMISSES
Plugging of this Well will be done in accordance will List Name of Company Representative authorized to be		Rules and Regulations of the State Corporation	CEIVED Commission.
Address: P O BOX 551		_ City / State: RUSSELL KS 67665	
Plugging Contractor: H-D OILFIELD SERVICE		KCC License #: 32970	
Address: P O BOX 87, BAZINE	any Name)	(Contractor's) Phone:	
Proposed Date and Hour of Plugging (if known?):W			- 14
Payment of the Plugging Fee (K.A.R. 82-3-118) will I Date: 5/6/09 Authorized Operator / A	pe guaranteed by operator or Age	ent (Signature)	Disty

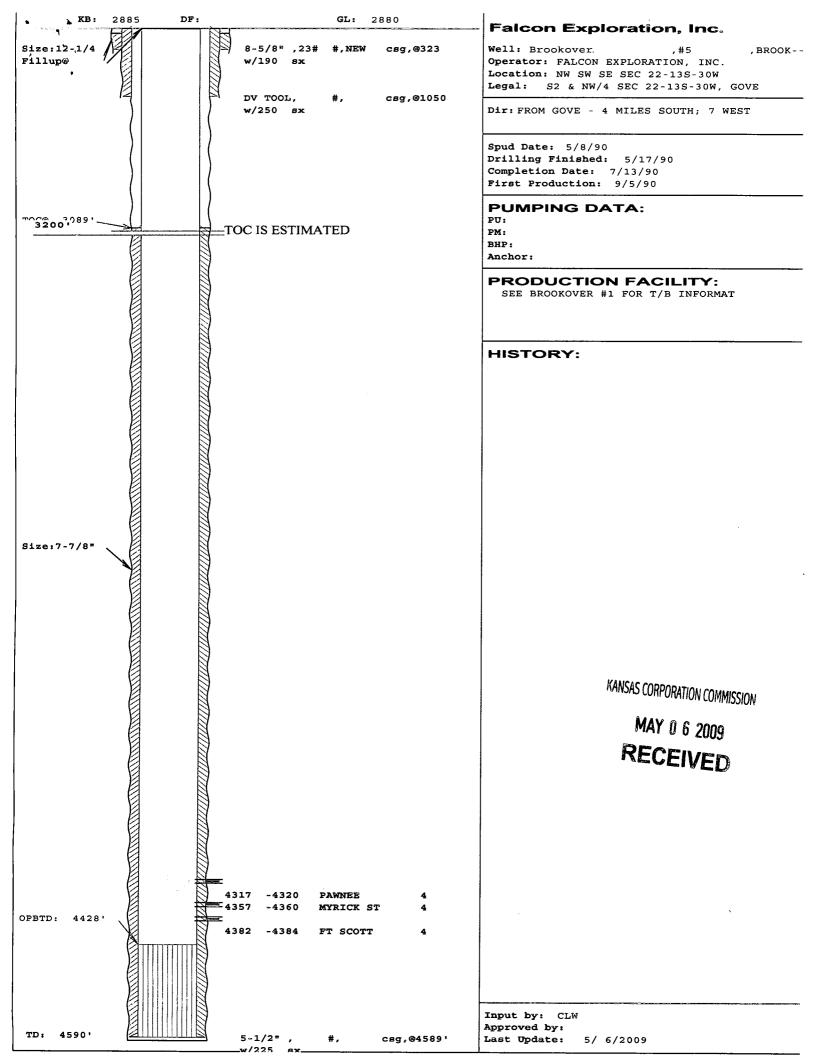



Mark Parkinson, Governor Thomas E. Wright, Chairman Michael C. Moffet, Commissioner Joseph F. Harkins, Commissioner

NOTICE OF RECEIPT OF WELL PLUGGING APPLICATION (CP-1)

FALCON EXPLORATION, INC. 125 N MARKET STE 1252 WICHITA, KS 67202-1719 May 08, 2009

Re: BROOKOVER #5

API 15-063-21328-00-00

22-13S-30W, 990 FSL 2310 FEL GOVE COUNTY, KANSAS

Dear Operator:

This letter is to notify you that the Conservation Division has received your plugging proposal, form CP-1, for the above well and has reviewed the proposal for completeness. The central office will now forward your CP-1 to the district office listed below for review of the proposed plugging method. Please contact the district office for approval of your proposed plugging method at least five (5) days before plugging the well, pursuant to K.A.R. 82-3-113(b). If a workover pit will be used during the plugging of the well it must be permitted. A CDP-1 form must be filed and approved prior to the use of the pit in accordance with K.A.R. 82-3-600.

The Conservation Division's review of form CP-1, either in the central or district office, does not include an inquiry into well ownership or the filing operator's legal right to plug the well. This notice in no way constitutes authorization to plug the above well by persons not having legal rights of ownership or interest in the well.

This notice is void after November 4, 2009. The CP-1 filing does not bring the above well into compliance with K.A.R. 82-3-111 with regard to the Commission's temporary abandonment requirements.

Sincerely,

Steve Bond

Steve Bond

Production Department Supervisor

District: #4 2301 E. 13th Hays, KS 67601

(785) 625-0550