## KANSAS CORPORATION COMMISSION OIL & GAS CONSERVATION DIVISION

· 600 4


## **WELL PLUGGING APPLICATION**

Please TYPE Form and File ONE Copy

Form CP-1 September 2003 This Form must be Typed Form must be Signed All blanks must be Filled

API # 15 - 155-21245 -00 00 (Identifier No.	umber of this well). This must be listed for wells drilled since 1967; if no API # was issued,
indicate original spud or completion date 4/21/93	
Well Operator: FALCON EXPLORATION INC.	KCC License #: 5316
Well Operator: FALCON EXPLORATION INC.  Address: 125 N. MARKET, SUITE 1252	City: (Operator's)
State: KS Zip Code	67202 Contact Phone: (316 ) 262 - 1378
Lease: KNOWLES TRUST Well #: 1  SW - NE - NE - NE Spot Location / QC	City: WICHITA  67202
Feet (in exact tootage) From East / Note that I have the conductor Casing Size:  Surface Casing Size: 8-5/8"  Feet (in exact tootage) From East / Note that I have the conductor	South (from nearest outside section corner) Line of Section (Not Lease Line)  Nest (from nearest outside section corner) Line of Section (Not Lease Line)  Cathodic Water Supply Well  IHR Docket # Other:  Cemented with: Sacks  Cemented with: Sacks  Cemented with: Sacks  Cemented with: Sacks
Condition of Well: Good Poor Casing Lo	—
Is Well Log attached to this application as required?	Is ACO-1 filed? Ves No APR 10 2009
Plugging of this Well will be done in accordance with K.S.A. 55-101 List Name of Company Representative authorized to be in charge of p	et, seg. and the Rules and Regulations of the State Corporation Commission.  lugging operations: LEON KUHN  Phone: (785) 483 - 1559
Address: P O BOX 551	City / State: RUSSELL, KS 67665
Plugging Contractor: H-D OILFIELD SERVICE INC.	KCC License #: 32970
(Company Name) Address: P O BOX 87, BAZINE KS 67516	(Contractor's) Phone: (785) 398 - 2289
Proposed Date and Hour of Plugging (if known?): APRIL 20, 2009	
Payment of the Plugging Fee (K.A.R. 82-3-118) will be guaranteed by Date: 4/16/09 Authorized Operator / Agent:	Operator or Agent (Signature)

Mail to: KCC - Conservation Division, 130 S. Market - Room 2078, Wichita, Kansas 67202

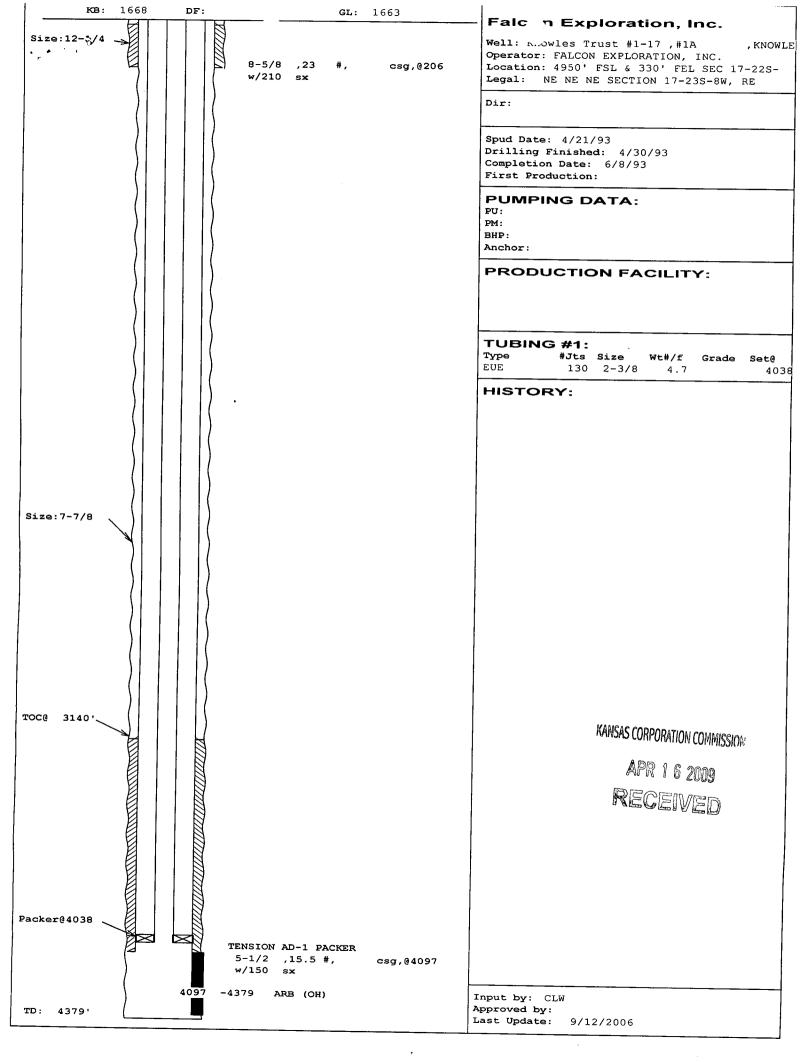



Mark Parkinson, Governor Thomas E. Wright, Chairman Michael C. Moffet, Commissioner Joseph F. Harkins, Commissioner

## NOTICE OF RECEIPT OF WELL PLUGGING APPLICATION (CP-1)

FALCON EXPLORATION, INC. 125 N MARKET STE 1252 WICHITA, KS 67202-1719

May 14, 2009

Re: KNOWLES TRUST #1-SWD API 15-155-21245-00-00 17-23S-8W, 4808 FSL 598 FEL RENO COUNTY, KANSAS

## Dear Operator:

This letter is to notify you that the Conservation Division has received your plugging proposal, form CP-1, for the above well and has reviewed the proposal for completeness. The central office will now forward your CP-1 to the district office listed below for review of the proposed plugging method. Please contact the district office for approval of your proposed plugging method at least five (5) days before plugging the well, pursuant to K.A.R. 82-3-113(b). If a workover pit will be used during the plugging of the well it must be permitted. A CDP-1 form must be filed and approved prior to the use of the pit in accordance with K.A.R. 82-3-600.

The Conservation Division's review of form CP-1, either in the central or district office, does not include an inquiry into well ownership or the filing operator's legal right to plug the well. This notice in no way constitutes authorization to plug the above well by persons not having legal rights of ownership or interest in the well.

This notice is void after November 10, 2009. The CP-1 filing does not bring the above well into compliance with K.A.R. 82-3-111 with regard to the Commission's temporary abandonment requirements.

Sincerely,

Steve Bond

Steve Bond

**Production Department Supervisor** 

District: #2

3450 N. Rock Road, Suite 601

Wichita, KS 67226 (316) 630-4000