

STATE OF KANSAS
STATE CORPORATION COMMISSION

WELL PLUGGING RECORD

Give All Information Completely
Make Required Affidavit
Mail or Deliver Report to
Conservation Division
State Corporation Comm.
245 North Water
Wichita, KS 67202

Gove County, Sec. 18 Twp. 11S Rge. 30W
Location as "NE/CNW $\frac{1}{4}$ SW $\frac{1}{4}$ " or footage from lines
100' S of C NW NE

Lease Owner Olympic Petroleum Company
Lease Name Sidles Well No. 1
Office Address 2121 South Columbia, Tulsa, Oklahoma 74114
Character of Well (Completed as Oil, Gas or Dry Hole)


Dry Hole

Date Well completed 9/25/80 19
Application for plugging filed 9/25/80 19
Application for plugging approved 9/25/80 19
Plugging commenced 9/25/80 19
Plugging completed 9/25/80 10:30 a.m. 19
Reason for abandonment of well or producing formation

If a producing well is abandoned, date of last production 19

Was permission obtained from the Conservation Division or its agents before plugging was commenced? Yes

Name of Conservation Agent who supervised plugging of this well Gil Balthazor
Producing formation Depth to top Bottom Total Depth of Well
Show depth and thickness of all water, oil and gas formations. RTD 4645'

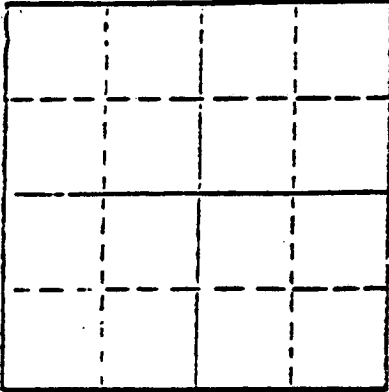

Locate well correctly on above Section Plat

OIL, GAS OR WATER RECORDS

CASING RECORD

FORMATION	CONTENT	FROM	TO	SIZE	PUT IN	PULLED OUT
	Surface	0	257'	8-5/8"	yes	no

Describe in detail the manner in which the well was plugged, indicating where the mud flux was placed and the method or methods used in introducing it into the hold. If cement or other plugs were used, state the character of same and depth placed, from feet to feet for each plug set.

1st plug @ 1200' with 70 sacks
2nd plug @ 250' with 30 sacks
3rd plug @ 40' with 10 sacks
5 sacks in rathole
Job complete @ 10:30 a.m. 9/25/80

RECEIVED
STATE CORPORATION COMMISSION
10-15-1980
OCT 15 1980
CONSERVATION DIVISION
Wichita, Kansas

(If additional description is necessary, use BACK of this sheet)

Name of Plugging Contractor Slawson Drilling Company, Inc.

STATE OF Kansas COUNTY OF Sedgwick, ss.
James C. Remsberg, Slawson Drilling Co., Inc. (employee of owner) or (owner or operator) of the above-described well, being first duly sworn on oath, says: That I have knowledge of the facts, statements, and matters herein contained and the log of the above-described well as filed and that the same are true and correct. So help me God.

(Signature) James C. Remsberg
James C. Remsberg
200 Douglas Building, Wichita, Kansas 67202
(Address)

SUBSCRIBED AND SWORN TO before me this 14 day of October, 1980

Mary Lou Taylor
Mary Lou Taylor Notary Public.

My commission expires January 17, 1981



DRILLERS LOG

OPERATOR: Olympic Petroleum Company
 2121 South Columbia
 Tulsa, Oklahoma 74114

WELL NAME: Sidles #1
 100' S of C NW NE Sec. 18-11S-30W
 Gove County, Kansas

CONTRACTOR: Slawson Drilling Company, Inc.
 200 Douglas Building
 Wichita, Kansas 67202

COMMENCED: 9/13/80

COMPLETED: 9/25/80 10:30 a.m.

RTD: 4645'

SURFACE CASING: 8-5/8" set at 257' with 175sx cement

0' to 260' 12 1/2" Surface Hole
 260' to 580' Shale
 580' to 1620' Shale & Shells
 1620' to 2465' Shale
 2465' to 2490' Anhydrite
 2490' to 3096' Shale
 3096' to 3971' Lime & Shale
 3971' to 4150' Lime
 4150' to 4220' Lime & Shale
 4220' to 4256' Lansing K.C.
 4256' to 4284' Lansing K.C. (Lime)
 4284' to 4420' Lime & Shale
 4420' to 4450' Lime
 4450' to 4645' Lime & Shale
 RTD 4645'

STATE OF KANSAS

COUNTY OF SEDGWICK

I, James C. Remsberg, of the Slawson Drilling Company, Inc.
 hereby state the above is an accurate copy of the Sidles #1 log for
 Olympic Petroleum Company.

James C. Remsberg
 James C. Remsberg
 Wichita, Kansas

RECEIVED
 STATE CORPORATION COMMISSION
 10-15-1980
 OCT 15 1980
 CONSERVATION DIVISION
 WICHITA, KANSAS

Subscribed and sworn to me
 this 14th day of October, 1980

Mary Lou Taylor
 Mary Lou Taylor, Notary

My commission expires January 17, 1981

