


WELL PLUGGING RECORD

Give All Information Completely  
Make Required Affidavit  
Mail or Deliver Report to:  
Conservation Division  
State Corporation Commission  
212 No. Market  
Wichita, Kansas

Gove County, Sec. 34 Twp. 11 Rge. 30 (E) (W)

Location as "NE/CNWSW" or footage from lines SE SE SW  
Lease Owner Helberg Oil Company  
Lease Name Little Well No. #1  
Office Address Box 32 Morland, Ks. 67650  
Character of Well (completed as Oil, Gas or Dry Hole) Dry Hole  
Date well completed 4-11 19 82  
Application for plugging filed 4-11 19 82  
Application for plugging approved 4-11 19 82  
Plugging commenced 4-11 19 82  
Plugging completed 4-11 19 82  
Reason for abandonment of well or producing formation Dry hole

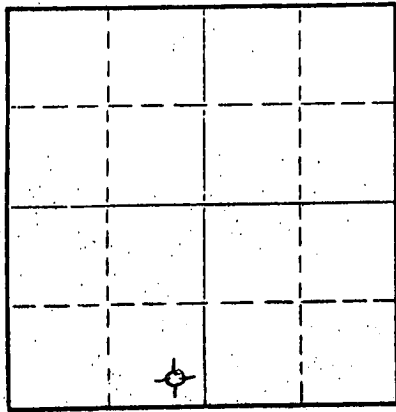

Locate well correctly on above Section Plat

If a producing well is abandoned, date of last production 19  
Was permission obtained from the Conservation Division or its agents before plugging was commenced? Yes  
Name of Conservation Agent who supervised plugging of this well Carl Goodrow

Producing formation \_\_\_\_\_ Depth to top \_\_\_\_\_ Bottom \_\_\_\_\_ Total Depth of Well 4572' Feet  
Show depth and thickness of all water, oil and gas formations.

OIL, GAS OR WATER RECORDS

CASING RECORD

FORMATION	CONTENT	FROM	TO	SIZE	PUT IN	PULLED OUT
Surface		0	203	8 5/8"	203	0

Describe in detail the manner in which the well was plugged, indicating where the mud fluid was placed and the method or methods used in introducing it into the hole. If cement or other plugs were used, state the character of same and depth placed, from \_\_\_\_\_ feet to \_\_\_\_\_ feet for each plug set.

1st. Plug set at 1380' with 80 sacks common cement 50-50poz 4% Gel 1% Cal Cl

2nd. Plug set at 230' with 40 sacks common cement 50-50poz 4% Gel 1% Cal Cl

3rd. Plug set at 40' with 10 sacks common cement 50-50poz 4% Gel 1% Cal Cl

10 sacks in rathole

Heavy drilling mud between each plug.

(If additional description is necessary, use BACK of this sheet)

Name of Plugging Contractor Sun Oilwell Cementing  
Address Oakely, Kansas

STATE OF Kansas, COUNTY OF Graham ss.  
Jerry M. Helberg (employee of owner) or (owner or operator) of the above-described

well, being first duly sworn on oath, says: That I have knowledge of the facts, statements, and matters herein contained and the log of the above-described well as filed and that the same are true and correct. So help me God.

(Signature) Jerry M. Helberg  
Box 32 Morland, Ks. 67650  
(Address)



Subscribed and sworn to before me this 10 day of May, 1982  
My commission expires Dec. 4, 1983

RECEIVED  
STATE CORPORATION COMMISSION  
5-11-1982  
MAY 11 1982  
CONSERVATION DIVISION  
Wichita, Kansas