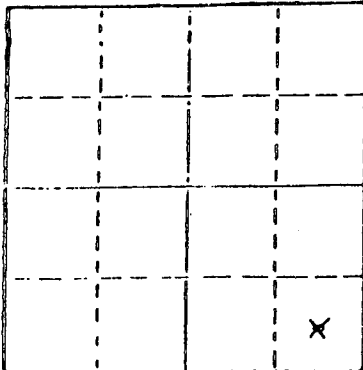


STATE OF KANSAS
STATE CORPORATION COMMISSION

WELL PLUGGING RECORD

Give All Information Completely
Make Required Affidavit
Mail or Deliver Report to
Conservation Division
State Corporation Comm.
245 North Water
Wichita, KS 67202

Locate well correctly on above
Section Plot

Logan County, Sec. 1 Twp. 11 Rge. 32 E/W
Location as "NE/CNW/SW" or footage from lines
SE SE - 660 N 660 W
Lease Owner Ostmeyer & Senior
Lease Name Steinle # 1 Well No. # 1
Office Address Western Well & Pump, Inc., Colby, Kansas 67701
Character of Well (Completed as Oil, Gas or Dry Hole)
Dry hole
Date Well completed 5/11 1979
Application for plugging filed 5/11 1979
Application for plugging approved 5/11 1979
Plugging commenced 5/11 1979
Plugging completed 5/11 1979
Reason for abandonment of well or producing formation

Dry hole
If a producing well is abandoned, date of last production 19

Was permission obtained from the Conservation Division or
its agents before plugging was commenced? yes

Name of Conservation Agent who supervised plugging of this well Gilbert Balthazor
Producing formation Depth to top Bottom Total Depth of Well 1091'
Show depth and thickness of all water, oil and gas formations.

OIL, GAS OR WATER RECORDS

CASING RECORD

FORMATION	CONTENT	FROM	TO	SIZE	PUT IN	PULLED OUT
Surface Casing		0	327'	6 5/8"	327'	0

Describe in detail the manner in which the well was plugged, indicating where the mud fluid
was placed and the method or methods used in introducing it into the hold. If cement or other
plugs were used, state the character of same and depth placed, from feet to
feet for each plug set.

50 sk @ 1000'
20 sk @ 300'
10 sk @ 40'
50-50 pos 6% gel

RECEIVED
STATE CORPORATION COMMISSION
7-17-1979
JUL 17 1979

(If additional description is necessary, use BACK of this sheet)
Name of Plugging Contractor Western Well & Pump, Inc. CONSERVATION DIVISION
Wichita, Kansas

STATE OF Kansas COUNTY OF Thomas, ss.
(employee of owner) or (owner or operator)
of the above-described well, being first duly sworn on oath, says: That I have knowledge of
the facts, statements, and matters herein contained and the log of the above-described well
as filed and that the same are true and correct. So help me God.


(Signature) Roy F. Senior L.

SUBSCRIBED AND SWORN TO before me this 11th day of June, 1979

Del Meris

Notary Public.

My commission expires May 18 1980

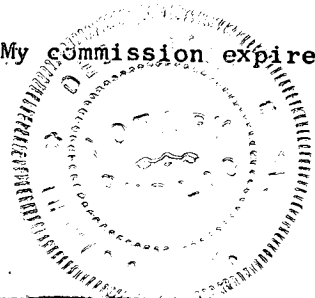

WESTERN WELL & PUMP INC
Roy Senior

Roy Senior

A 2x2 grid with 'N' above the top-right cell and 'W' to the left of the top-left cell.

DRILLERS' NAME: Wayne Gregory

JUL 17 1979
 7-17-1979
 CONSERVATION DIVISION
 Wichita, Kansas

ESTIMATED CAPACITY: