


STATE OF KANSAS
STATE CORPORATION COMMISSION

WELL PLUGGING RECORD

Give All Information Completely
Make Required Affidavit
Mail or Deliver Report to
Conservation Division
State Corporation Comm.
245 North Water
Wichita, KS 67202

Logan County. Sec. 4 Twp. 11S Rge. 32 R/W
Location as "NE/CNW1SW1" or footage from lines _____
SW SE SE
Lease Owner George R. Jones
Lease Name Oakley Industries Well No. #1
Office Address 125 N. Market - Suite 1310, Wichita, Ks.
Character of Well (Completed as Oil, Gas or Dry Hole) _____

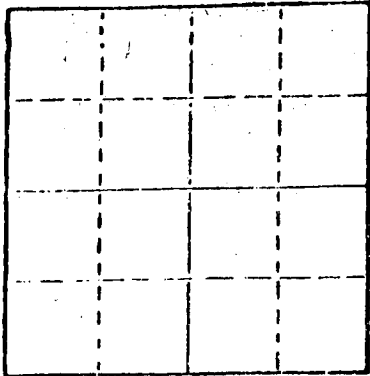

Locate well correctly on above
Section Plot

Dry Hole
Date Well completed 3-3-81 19
Application for plugging filed 3-2-81 19
Application for plugging approved 3-2-81 19
Plugging commenced 3-2-81 19
Plugging completed 3-3-81 19
Reason for abandonment of well or producing formation
Commercial quantities of oil not found
If a producing well is abandoned, date of last production
19

Was permission obtained from the Conservation Division or
its agents before plugging was commenced? Yes

Name of Conservation Agent who supervised plugging of this well Gilbert Balthazor
Producing formation _____ Depth to top _____ Bottom _____ Total Depth of Well 4660'
Show depth and thickness of all water, oil and gas formations.

OIL, GAS OR WATER RECORDS

CASING RECORD

FORMATION	CONTENT	FROM	TO	SIZE	PUT IN	PULLED OUT
				8 5/8"	284'	None

Describe in detail the manner in which the well was plugged, indicating where the mud fluid was placed and the method or methods used in introducing it into the hold. If cement or other plugs were used, state the character of same and depth placed, from _____ feet to _____ feet for each plug set.

Plug @ 1550' w/60 sx.
Plug @ 300' w/30 sx.
Plug @ 40' w/10 sx.
Rat Hole 5 sx.

RECEIVED
STATE CORPORATION COMMISSION
APR 29 1981
CONSERVATION DIVISION
Wichita, Kansas

(If additional description is necessary, use BACK of this sheet)

Name of Plugging Contractor Rains & Williamson Oil Co., Inc.

STATE OF Kansas COUNTY OF Sedgwick, ss.
Wilson Rains, President of Rains & Williamson Oil Co., Inc. (employee of owner) or (owner or operator) of the above-described well, being first duly sworn on oath, says: That I have knowledge of the facts, statements, and matters herein contained and the log of the above-described well as filed and that the same are true and correct. So help me God.

(Signature) Wilson Rains
435 Page Court, 220 W. Douglas, Wichita, Ks. 67202
(Address)

SUBSCRIBED AND SWORN TO before me this 6 day of March, 19 81

Juanita M. Green
Notary Public.

My commission expires 10-4-83



20 copies to host
3/9/81
copy to host
3-10-81

DRILLER'S LOG

MAR 9 1981

15-109-20166-00-00

COMPANY: George R. Jones

SEC. 4 T. 11S R. 32S

WELL NAME: Oakley Industries #1

LOC. SW SE SE

COUNTY: Logan

RIG NO. #11

TOTAL DEPTH 4660'

ELEVATION

COMMENCED: 2-21-81

COMPLETED: 3-3-81

CONTRACTOR: Rains & Williamson Oil Co., Inc.

CASING RECORD:

SURFACE: 8 5/8" @ 284' w/200 sx. 60/40 poz., 2% gel, 3% cc.

PRODUCTION: D&A

LOG

(Figures Indicate Bottom of Formations)

Shale	4020
Lime & Shale	4325
Lime	4660
<u>ROTARY TOTAL DEPTH</u>	<u>4660</u>

RECEIVED
 STATE CORPORATION COMMISSION
 4-29-1981
 APR 29 1981
 CONSERVATION DIVISION
 Wichita, Kansas

STATE OF Kansas)
 COUNTY OF Sedgwick) SS:

I, Wilson Rains, President of Rains & Williamson Oil Co., Inc.
 upon oath state that the above and foregoing is a true and correct copy of the log of the
Oakley Industries #1 well.

Wilson Rains
 Wilson Rains



Subscribed and sworn to before me this 6 day of March, 1981.

My Appointment Expires:
10-4-83

Juanita M. Green
 Juanita M. Green

2 copies
 Rec'd
 3/29/81