

NOTICE OF INTENTION TO DRILL

(see rules on reverse side)

Starting Date 2 5 86 month day year

API Number 15- 063-2,010-00-00

OPERATOR: License # 5011 Name Viking Resources Address 217 E. William City/State/Zip Wichita, KS 67202-4005 Contact Person Jim Devlin Phone 316-262-2502

NE SW SW Sec. 21 Twp. 11 S, Rg. 31 X West 990 Ft. from South Line of Section 4290 Ft. from East Line of Section

(Note: Locate well on Section Plat on reverse side)

CONTRACTOR: License # Name Unknown City/State

Nearest lease or unit boundary line 330 feet

County Gove

Lease Name Wieland Well # 3

Ground surface elevation 2925 est. feet MSL

Well Drilled For: Well Class: Type Equipment: X Oil SWD X Infield X Mud Rotary Gas Inj Pool Ext Air Rotary OWWO Expl Wildcat Cable

Domestic well within 330 feet: yes X no

Municipal well within one mile: yes X no

Surface pipe by Alternate: 1 2 X

Depth to bottom of fresh water 150

Depth to bottom of usable water 1525

Surface pipe planned to be set 240+

Projected Total Depth 4650 feet

Formation Mississippian

If OWWO: old well info as follows:

Operator Well Name Comp Date Old Total Depth

I certify that well will comply with K.S.A. 55-101, et seq., plus eventually plugging hole to KCC specifications.

Date 21 Jan 1986 Signature of Operator or Agent James B. Devlin Title Operator

For KCC Use:

Conductor Pipe Required feet; Minimum Surface Pipe Required 200 feet per Alt X 2

This Authorization Expires 7-23-86 Approved By 1-23-86

Handwritten signature: James B. Devlin


Handwritten initials and numbers: X 2

Must be filed with the K.C.C. five (5) days prior to commencing well  
This card void if drilling not started within six (6) months of date received by K.C.C.

### Important procedures to follow:

1. Notify District office before setting surface casing.
2. Set surface casing by circulating cement to the top.
3. File completion forms ACO-1 with K.C.C. within 90 days of well completion, following instructions on ACO-1, side 1, and including copies of wireline logs.
4. Notify District office 48 hours prior to old well workover or re-entry.
5. Prior to filing Intent, prepare a proposed plugging plan in case well is D & A, then obtain approval of plan when calling district office prior to setting surface pipe.
6. Submit plugging report (CP-4) to K.C.C. after plugging is completed.
7. Obtain an approved injection docket number before disposing of salt water.
8. Notify K.C.C. within 10 days when injection commences or terminates.
9. If an alternate 2 completion, cement in the production pipe from below any usable water to surface within 120 days of spud date.

### A Regular Section of Land 1 Mile = 5,280 Ft.

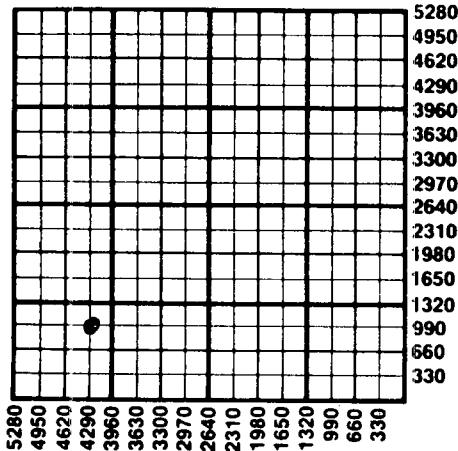

RECEIVED  
STATE OF KANSAS  
1-23-1986  
JAN 25 1986  
DIVISION

State Corporation Commission of Kansas  
Conservation Division  
200 Colorado Derby Building  
Wichita, Kansas 67202  
(316) 263-3238