

NOTICE OF INTENTION TO DRILL

(see rules on reverse side)

Starting Date March 10, 1987 month day year

API Number 15- 063-21093-00-00

OPERATOR: License # 8541

NE NW NE Sec. 22 Twp. 11S S, Rg. 31 East West

Name PETEX, Inc.

Address Route 2, Box 553

City/State/Zip Rogersville, MO 65742

Contact Person Larry Childress

Phone 417-887-6289

4950 Ft. from South Line of Section

1650 Ft. from East Line of Section

(Note: Locate well on Section Plat on reverse side)

Nearest lease or unit boundary line 330 feet

County Gove

CONTRACTOR: License # 9087

Lease Name Meorian Well # 1

Name R and C Drilling Co. Inc.

Ground surface elevation 2973 feet MSL

City/State Hays, KS

Domestic well within 330 feet: yes no

Well Drilled For: Well Class: Type Equipment:

Municipal well within one mile: yes no

X Oil SWD Infield Mud Rotary

Depth to bottom of fresh water 160

Gas Inj Pool Ext Air Rotary

Depth to bottom of usable water 1500

OWWO Expl Wildcat Cable

Surface pipe by Alternate: 1 2 X

If OWWO: old well info as follows:

Surface pipe planned to be set 210

Operator

Conductor pipe required n/a

Well Name

Projected Total Depth 4650 feet

Comp Date Old Total Depth

Formation Miss

I certify that well will comply with K.S.A. 55-101, et seq., plus eventually plugging hole to KCC specifications.

Date 2/4/87 Signature of Operator or Agent Larry Childress Title President

For KCC Use:

Conductor Pipe Required feet; Minimum Surface Pipe Required 210 feet per Alt. 4

This Authorization Expires 8-9-87 Approved By 2-9-87


Handwritten signature and initials at bottom right.

Must be filed with the K.C.C. five (5) days prior to commencing well
 This card void if drilling not started within six (6) months of date received by K.C.C.

Important procedures to follow:

1. Notify District office before setting surface casing.
2. Set surface casing by circulating cement to the top.
3. File completion forms ACO-1 with K.C.C. within 90 days of well completion, following instructions on ACO-1, side 1, and including copies of wireline logs.
4. Notify District office 48 hours prior to old well workover or re-entry.
5. Prior to filing Intent, prepare a proposed plugging plan in case well is D & A, then obtain approval of plan when calling district office prior to setting surface pipe.
6. Submit plugging report (CP-4) to K.C.C. after plugging is completed.
7. Obtain an approved injection docket number before disposing of salt water.
8. Notify K.C.C. within 10 days when injection commences or terminates.
9. If an alternate 2 completion, cement in the production pipe from below any usable water to surface within 120 days of spud date.

**A Regular Section of Land
 1 Mile = 5,280 Ft.**

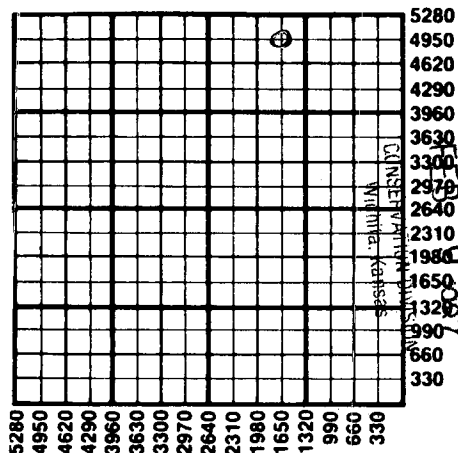

STATE CORPORATION COMMISSION

2-9-1987

State Corporation Commission of Kansas
 Conservation Division
 200 Colorado Derby Building
 Wichita, Kansas 67202
 (316) 263-3238