

CARD MUST BE TYPED

# NOTICE OF INTENTION TO DRILL

(see rules on reverse side)

CARD MUST BE SIGNED

Starting Date: 7/4/85  
..... month day year

API Number 15- 063-20,933.00-00

OPERATOR: License # 8541  
Name PETEX, Inc.  
Address Route 2, Box 553  
City/State/Zip Rogersville, MO 65742  
Contact Person Larry Childress  
Phone (417) 887-6289

NE. NE. NE. Sec 17. Twp 11. S, Rge 31.  East  West  
(location)

4950 Ft North from Southeast Corner of Section  
330 Ft West from Southeast Corner of Section  
(Note: Locate well on Section Plat on reverse side)

CONTRACTOR: License # 9 5104  
Name Blue Goose Drilling, Inc.  
City/State Great Bend, Kansas

Nearest lease or unit boundary line 330 feet  
County Gove  
Lease Name Engel Well# 1 "A"

Well Drilled For: Well Class: Type Equipment:  
 Oil  Swd  Infield  Mud Rotary  
 Gas  Inj  Pool Ext.  Air Rotary  
 OWWO  Expl  Wildcat  Cable

Domestic well within 330 feet:  yes  no  
Municipal well within one mile:  yes  no

If OWWO: old well info as follows:  
Operator .....  
Well Name .....  
Comp Date ..... Old Total Depth .....  
Projected Total Depth 4,600 feet  
Projected Formation at TD Miss  
Expected Producing Formations Lansing - KC

Depth to Bottom of fresh water 150 feet  
Lowest usable water formation Dakota  
Depth to Bottom of usable water 1600 feet  
Surface pipe by Alternate: 1  2   
Surface pipe to be set 200 feet  
Conductor pipe if any required n/a feet  
Ground surface elevation 3006 feet MSL  
This Authorization Expires 12-17-85  
Approved By 9.6-17-85

I certify that we will comply with K.S.A. 55-101, et seq., plus eventually plugging hole to K.C.C. specifications.

Date 6/15/85 Signature of Operator or Agent Larry Childress

MHC/JUDHE 6-17-85  
President


Form C-1 4/84

\* AT T.D. PRODUCTION STRING WILL BE SET IMMEDIATELY OR WELL WILL BE PLUGGED

Must be filed with the K.C.C. five (5) days prior to commencing well  
This card void if drilling not started within six (6) months of date received by K.C.C.

**Important procedures to follow :**

**A Regular Section of Land**  
**1 Mile = 5,280 Ft.**

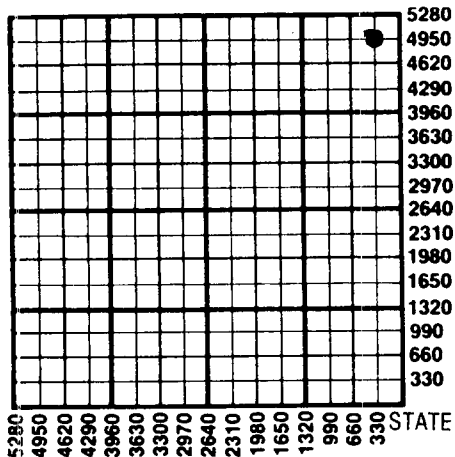

1. Notify District office before setting surface casing.
2. Set surface casing by circulating cement to the top.
3. File completion forms ACO-1 with K.C.C. within 90 days of well completion, following instructions on ACO-1, side 1, and including copies of wireline logs.
4. Notify District office 48 hours prior to old well workover or re-entry.
5. Prior to plugging, prepare a plugging plan, then obtain agreement from the appropriate district office for an approved plugging plan.
6. Submit plugging report (CP-4) to K.C.C. after plugging is completed.
7. Obtain an approved injection docket number before disposing of salt water.
8. Notify K.C.C. within 10 days when injection commences or terminates.
9. If an alternate 2 completion, cement in the production pipe from below usable water to surface within 120 days of spud date.

RECEIVED

6-17-1985  
JUN 17 1985

CONSERVATION DIVISION  
Wichita, Kansas

STATE CORPORATION COMMISSION  
State Corporation Commission of Kansas  
Conservation Division  
200 Colorado Derby Building  
Wichita, Kansas 67202  
(316) 263-3238