

STATE OF KANSAS
STATE CORPORATION COMMISSION

WELL PLUGGING RECORD

Give All Information Completely
Make Required Affidavit
Mail or Deliver Report to
Conservation Division
State Corporation Comm.
245 North Water
Wichita, KS 67202

Gove County, Sec. 17 Twp. 11 Rge. 31 E/W
Location as "NE/CNW $\frac{1}{4}$ SW $\frac{1}{4}$ " or footage from lines
C NW NW

Lease Owner William E. Wise
Lease Name Pioneer Well No. 1

Office Address 7720 E. Belleview Ave., Englewood, Colo. 80111

Character of Well (Completed as Oil, Gas or Dry Hole)
Dry Hole

Date Well completed June 19 1981

Application for plugging filed June 22 1981

Application for plugging approved 19

Plugging commenced June 19 1981

Plugging completed June 19 1981

Reason for abandonment of well or producing formation
No commercial Shows


If a producing well is abandoned, date of last production
19

Was permission obtained from the Conservation Division or
its agents before plugging was commenced? Yes

Name of Conservation Agent who supervised plugging of this well Gil Balthazor

Producing formation None Depth to top Bottom Total Depth of Well 4708

Show depth and thickness of all water, oil and gas formations.

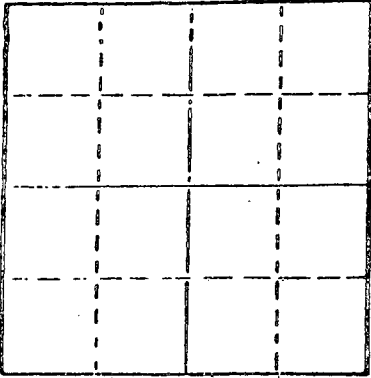

Locate well correctly on above
Section Plot

OIL, GAS OR WATER RECORDS

CASING RECORD

FORMATION	CONTENT	FROM Surface	TO	SIZE	PUT IN	PULLED OUT
			309	8 5/8	304	None

Describe in detail the manner in which the well was plugged, indicating where the mud fluid was placed and the method or methods used in introducing it into the hold. If cement or other plugs were used, state the character of same and depth placed, from _____ feet to _____ feet for each plug set.

1550' to 1300'	60 Sacks 50/50 Pozmix 6% Gel			Pump Truck		
320' to 200'	30 Sacks 50/50 Pozmix 6% Gel			Pump Truck		
40' to Surface	10 Sacks 50/50 Pozmix 6% Gel			Pump Truck		
Intervening intervals filled with 9.3 lb./gal mud						
Rat hole	5 Sacks 50/50 Pozmix 6% Gel			Pump Truck		

RECEIVED
STATE CORPORATION COMMISSION
JUN 26 1981
CONSERVATION DIVISION
Wichita, Kansas

(If additional description is necessary, use BACK of this sheet)

Name of Plugging Contractor Sun Oil Well Cementing

STATE OF Colorado

COUNTY OF Arapahoe

ss.

(employee of owner) or (owner or operator)
of the above-described well, being first duly sworn on oath, says: That I have knowledge of the facts, statements, and matters herein contained and the log of the above-described well as filed and that the same are true and correct. So help me God.

(Signature)

7720 E. Belleview Ave., Englewood, Colo. 80111

(Address)

SUBSCRIBED AND SWORN TO before me this 22nd day of June, 1981

Pety Goedrich

Notary Public.

My commission expires

2-14-82

