


STATE OF KANSAS  
STATE CORPORATION COMMISSION  
CONSERVATION DIVISION  
P. O. BOX 17027  
WICHITA, KANSAS 67217

WELL PLUGGING RECORD

Rooks County, Sec. 6 Twp. 10 Rge. 17 (E) W(W)  
Location as "NE/CNW&SW" or footage from lines NW-NW-NW  
Lease Owner D. J. Markley  
Lease Name Posgate Well No. 2  
Office Address 211 W. 36th Hays, Kansas  
Character of Well (completed as Oil, Gas or Dry Hole) Oil  
Date well completed \_\_\_\_\_ 19\_\_\_\_  
Application for plugging filed June 19 80  
Application for plugging approved June 30, 19 80  
Plugging commenced August 25 19 80  
Plugging completed August 27 19 80  
Reason for abandonment of well or producing formation Dakota Broke in, 1500'  
filled up with sand ect.  
If a producing well is abandoned, date of last production April 28 19 78  
Was permission obtained from the Conservation Division or its agents before plugging was commenced? Yes

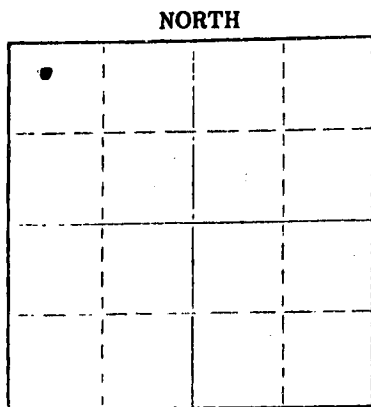

Locate well correctly on above Section Plot

Name of Conservation Agent who supervised plugging of this well Marion Schmidt  
Producing formation K.C. Depth to top 3270 Bottom 3570 Total Depth of Well 3590 Feet  
Show depth and thickness of all water, oil and gas formations.

OIL, GAS OR WATER RECORDS

CASING RECORD

FORMATION	CONTENT	FROM	TO	SIZE	PUT IN	PULLED OUT
				8 5/8	129' 178'	None
Lansing K.C.		3270	3570	4 1/2	3590'	None

Describe in detail the manner in which the well was plugged, indicating where the mud fluid was placed and the method or methods used in introducing it into the hole. If cement or other plugs were used, state the character of same and depth placed, from \_\_\_\_\_ feet to \_\_\_\_\_ feet for each plug set.

August 25, 1980 Put in with pump truck 140 sks Pozmix, 6% gel, 4 sks Hulls, as follows: -- 40 sks cement, 1 sk Hulls in annulus with max Pressure 250#.  
4 1/2" casing Put in 25 sks cement, 3 Hulls, 75 sks cement with Max Pressure 500#  
August 27, 1980--- Returned to location, found cement dropped 140' in 4 1/2" put in 1/2 yd redi-mix & filled to surface.

(If additional description is necessary, use BACK of this sheet)

Name of Plugging Contractor John B. Collins dba B-J Oil Co. Allied Cementing Co.  
Address Hays, Kansas Russell, Kansas

STATE OF KANSAS COUNTY OF ELLIS ss.  
D. J. Markley (employee of owner) or (owner) operator of the above-described well, being first duly sworn on oath, says: That I have knowledge of the facts, statements, and matters herein contained and the log of the above-described well as filed and that the same are true and correct. So help me God.

(Signature) D. J. Markley  
211 West 36th Street, Hays, Kansas 67601  
(Address)

SUBSCRIBED AND SWORN TO before me this 26th day of August, 19 80

My commission expires  **ARILLA A. MIZELL**  
Ellis County, Kansas  
My Appt. Exp. Nov. 25, 1982

Arilla A. Mizell  
Notary Public.

RECEIVED  
STATE CORPORATION COMMISSION  
SEP - 2 1980  
CONSERVATION DIVISION  
Wichita, Kansas