

WELL PLUGGING RECORD

Give All Information Completely  
Make Required Affidavit  
Mail or Deliver Report to:  
Conservation Division  
State Corporation Commission  
211 No. Broadway  
Wichita, Kansas

Rocks \_\_\_\_\_ County, Sec. 6 Twp. 10 Rge. 17 (E) \_\_\_\_\_ (W) \_\_\_\_\_

Location as "NE/CNW%SW%" or footage from lines. SE SE SW

Lease Owner Davis Brothers

Lease Name Bice Well No. 1

Office Address 500 McFarland Building Tulsa, Oklahoma 74103

Character of Well (completed as Oil, Gas or Dry Hole) EOR RTKCC

Date well completed \_\_\_\_\_ 19\_\_

Application for plugging filed 10-12-70 19\_\_

Application for plugging approved 10-13-70 19\_\_


Plugging commenced 10-15-70 19\_\_

Plugging completed 10-22-70 19\_\_

Reason for abandonment of well or producing formation \_\_\_\_\_

If a producing well is abandoned, date of last production \_\_\_\_\_ 19\_\_

Was permission obtained from the Conservation Division or its agents before plugging was commenced? Yes

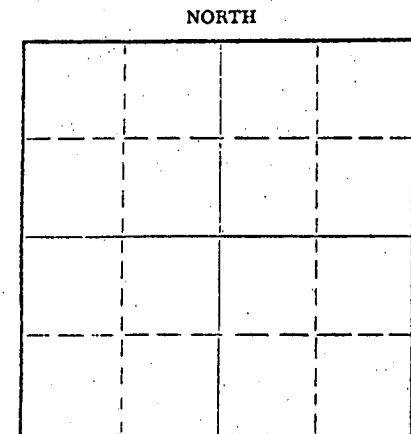

Name of Conservation Agent who supervised plugging of this well Leo Massey

Producing formation \_\_\_\_\_ Depth to top \_\_\_\_\_ Bottom \_\_\_\_\_ Total Depth of Well 3570 Feet

Show depth and thickness of all water, oil and gas formations.

OIL, GAS OR WATER RECORDS

CASING RECORD

FORMATION	CONTENT	FROM	TO	SIZE	PUT IN	PULLED OUT
				8 5/8	154	None
				4 1/2	3570	2299' .85

Describe in detail the manner in which the well was plugged, indicating where the mud fluid was placed and the method or methods used in introducing it into the hole. If cement or other plugs were used, state the character of same and depth placed, from \_\_\_\_\_ feet to \_\_\_\_\_ feet for each plug set.

Moved unit into location. Pushed a plug to 2750'; dumped 10' of sand and 4 sacks of cement. Cleaned on cellar. Spool off sand line and strung up double-sheave casing blocks. Had 13 1/2" tension at 1600 psi. Shot casing at 2318' and worked casing loose. Laid down 74 joints of casing. Put thread protectors on casing, tore down unit and moved off location. Halliburton squeezed well with 5 sacks of hulls, 30 sacks of mud and 120 sacks of pozmix with 6% gel.

RECEIVED  
STATE CORPORATION COMMISSION  
10-29-70 OCT 29 1970  
CONSERVATION DIVISION  
Wichita, Kansas

(If additional description is necessary, use BACK of this sheet)

Name of Plugging Contractor Forbes Casing Pulling Company, Inc.

Address P. O. Box 221 Great Bend, Kansas 67530

STATE OF Kansas, COUNTY OF Barton, ss. James W. Rockhold

(employee of owner) or (owner or operator) of the above-described well, being first duly sworn on oath, says: That I have knowledge of the facts, statements, and matters herein contained and the log of the above-described well, filed and that the same are true and correct. So help me God.

(Signature) James W. Rockhold

P. O. Box 221 Great Bend, Kansas

(Address)

SUBSCRIBED AND SWORN to before me this 26 day of October, 19 70

My commission expires May 27, 1973

Notary Public.

