


WELL PLUGGING RECORD

Give All Information Completely
Make Required Affidavit
Mail or Deliver Report to:
Conservation Division
State Corporation Commission
800 Bitting Building
Wichita, Kansas

NORTH

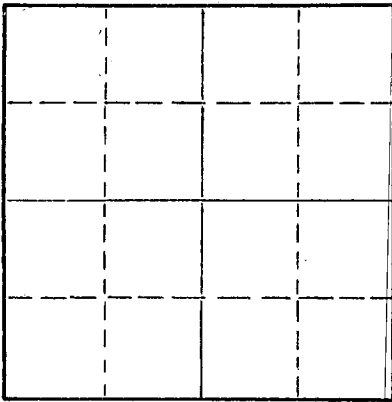

Locate well correctly on above Section Plat

Rooks County. Sec. 7 Twp. 10 Rge. (E) 17 (W)

Location as "NE/CNW/SW" or footage from lines SE SW NW
Lease Owner Iron Drilling Company
Lease Name Ross Well No. 1
Office Address 1206 Philtower Bldg., Tulsa, Oklahoma
Character of Well (completed as Oil, Gas or Dry Hole) Dry Hole
Date well completed May 29, 1956 19
Application for plugging filed " 19
Application for plugging approved " 19
Plugging commenced " 19
Plugging completed " 19
Reason for abandonment of well or producing formation Dry Hole

If a producing well is abandoned, date of last production None 19
Was permission obtained from the Conservation Division or its agents before plugging was commenced? Yes

Name of Conservation Agent who supervised plugging of this well Eldon Petty
Producing formation None Depth to top _____ Bottom _____ Total Depth of Well 3680 Feet
Show depth and thickness of all water, oil and gas formations.

OIL, GAS OR WATER RECORDS

CASING RECORD

FORMATION	CONTENT	FROM	TO	SIZE	PUT IN	PULLED OUT
Topeka		3051		8-5/8"	146	None
Heebner		3267				
Lansing		3312				
Conglomerate		3545				
Simpson		3611				
Arbuckle		3680				

Describe in detail the manner in which the well was plugged, indicating where the mud fluid was placed and the method or methods used in introducing it into the hole. If cement or other plugs were used, state the character of same and depth placed, from _____ feet to _____ feet for each plug set.

Filled hole with heavy mud to 150 feet. Set wood plug w/ 1/2 sack hulls and 15 sacks of cement. Mud to 40' set wood plug 1/2 sack hulls and 10 sacks of cement.

6-12-56


Name of Plugging Contractor Iron Drilling Company
Address 1206 Philtower Bldg., Tulsa, Oklahoma

STATE OF Oklahoma, COUNTY OF Tulsa, ss. J. L. Stackpole (employee of owner) or (owner or operator) of the above-described well, being first duly sworn on oath, says: That I have knowledge of the facts, statements, and matters herein contained and the log of the above-described well as filed and that the same are true and correct. So help me God

(Signature) J. L. Stackpole
Tulsa, Oklahoma (Address)

SUBSCRIBED AND SWORN TO before me this 7th day of June, 19 56

My commission expires February 28, 1960 B. Michel Notary Public.

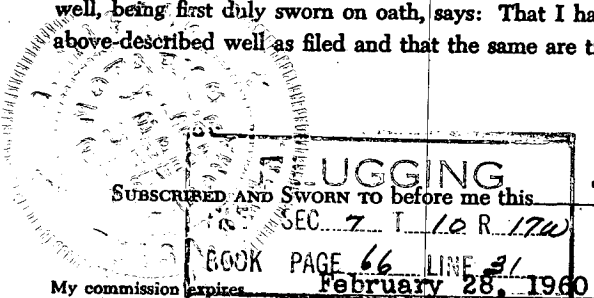

DRILLING RECORD

Well: No. 1 Ross
SE SW NW 7-10S-17W
Rocks County, Kansas

146' 8-5/8" OD Surface
Pipe cemented with 125
sacks.

Work Commenced: 5-18-56
Drilling Commenced: 5-18-56
Drilling Completed: 5-29-56
Work Completed: 5-30-56

Dry Hole no Oil String

WELL LOG

Shale	70	to	455
Shale & shells	455	to	500
Sand & shale	500	to	1070
Red bed	1070	to	1080
Sand	1080	to	1150
Shale & sand	1150	to	1275
Shale & shells	1275	to	1415
Anhydrite	1415	to	1453
Shale & shells	1453	to	1790
Shale & salt	1790	to	1880
Shale & shells	1880	to	1915
Shale - lime stks.	1915	to	2050
Lime & shale	2050	to	3151
Lime	3151	to	3191
Lime & shale	3191	to	3305
Lime	3305	to	3337
Kansas City lime	3337	to	3545
Conglomerate	3545	to	3665
Arbuckle	3665	to	3680 T.D.

PLUGGING
