

STATE OF KANSAS  
STATE CORPORATION COMMISSION

WELL PLUGGING RECORD

Give All Information Completely  
Make Required Affidavit  
Mail or Deliver Report to:  
Conservation Division  
State Corporation Commission  
800 Bittling Building  
Wichita, Kansas

NORTH

Section Plat grid with 5 rows and 4 columns.

Locate well correctly on above  
Section Plat

Rooks \_\_\_\_\_ County. Sec. 7 Twp. 10S Rge. 17 (E)W (W)  
Location as "NE/CNW 1/4 SW 1/4" or footage from lines SW SW SE  
Lease Owner Lee Phillips Oil Co.  
Lease Name Kleinschmidt Well No. 1  
Office Address 1407 Union Natl. Bk. Bldg., Wichita, Kansas  
Character of Well (completed as Oil, Gas or Dry Hole) dry  
Date well completed Sept. 2 19 52  
Application for plugging filed Sept. 2 19 52  
Application for plugging approved Sept. 2 19 52  
Plugging commenced Sept. 2 19 52  
Plugging completed Sept. 3 19 52  
Reason for abandonment of well or producing formation \_\_\_\_\_

If a producing well is abandoned, date of last production \_\_\_\_\_ 19\_\_\_\_  
Was permission obtained from the Conservation Division or its agents before plugging was commenced? yes

Name of Conservation Agent who supervised plugging of this well Eldon Petty  
Producing formation \_\_\_\_\_ Depth to top \_\_\_\_\_ Bottom \_\_\_\_\_ Total Depth of Well 3711 Feet  
Show depth and thickness of all water, oil and gas formations.


OIL, GAS OR WATER RECORDS

CASING RECORD

Table with 7 columns: Formation, Content, From, To, Size, Put In, Pulled Out. One entry: Size 8 5/8", Put In 250'.

Describe in detail the manner in which the well was plugged, indicating where the mud fluid was placed and the method or methods used in introducing it into the hole. If cement or other plugs were used, state the character of same and depth placed, from \_\_\_\_\_ feet to \_\_\_\_\_ feet for each plug set.

3711' to 240' heavy mud  
Set bridge plug at 240 ft.  
15 sacks cement through drillpipe  
Heavy mud to 40 ft., set plug and 1/2 sack hulls on top of plug  
Cemented with 10 sacks

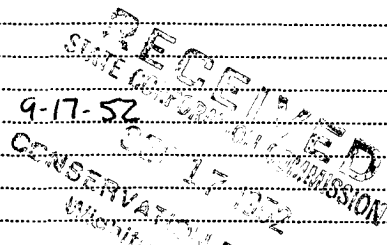

(If additional description is necessary, use BACK of this sheet)


Correspondence regarding this well should be addressed to Lee Phillips Oil Co.  
Address 1407 Union National Bank Bldg., Wichita, Kansas

STATE OF Kansas, COUNTY OF Sedgwick, ss. B. E. Ash (employee of owner) or (owner or operator) of the above-described well, being first duly sworn on oath, says: That I have knowledge of the facts, statements, and matters herein contained and the log of the above-described well as filed and that the same are true and correct. So help me God.

(Signature) B E Ash  
Ellinwood, Kansas (Address)

SUBSCRIBED AND SWORN to before me this 13th day of September, 19 52  
Eileen Hunke  
Notary Public.

My commission expires May 28, 1956

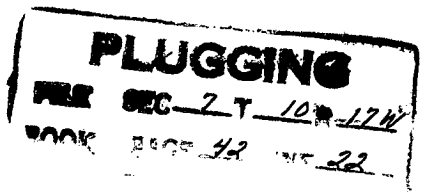

KLEINSCHMIDT #1

Rooks County, Kansas

Figures indicate bottom of formation:

	0 - 115 sand
	725 shale & shells
	760 red bed
	925 shale & shells
	1065 sand
	1330 shale, red rock & shells
	1428 shale
Well commenced	8-20-52
Well completed	9-2-52
Surface pipe set	250' of 8 5/8"
	1460 anhydrite
	1710 shale
	1930 shale & sand
	2035 shale & shells
	2074 lime & shale
	2130 broken lime
	2230 shale & shells
	2355 lime & shale
	2585 shale & shells
	2680 shale & lime
	2755 lime & shale
	2855 shale & shells
	2910 shale
	3065 shale & lime
	3135 shale & shells
	3180 lime & shale
	3400 shale & lime
	3545 lime
	3578 lime & shale
	3605 chirty conglomerate
	3635 conglomerate
	3670 conglomerate & Simpson
	3678 Simpson & green shale
	3711 Arbuckle - total depth

I, B. E. Ash, of the Ash-Mar drilling Co., upon oath state that the above and foregoing is a true and correct copy of the log of the #1 Kleinschmidt well.

B E Ash

Subscribed and sworn to before me this 13th day of September 1952.

*My Commission expires: 5/28/56*

Eileen Hunkle  
Notary Public

**PLUGGING**  
FILE SEC 2 T 10 R 12W  
BOOK PAGE 42 LINE 32

**RECEIVED**  
STATE CORPORATION COMMISSION  
SEP 17 1952  
CONSERVATION DIVISION  
Wichita, Kansas