

NOTICE OF INTENTION TO DRILL

(see rules on reverse side)

Expected Spud Date... 7... 31... 88... month day year

API Number 15- 109 - 20, 460 - 00 - 00

OPERATOR: License # 3372
Name Morrison-Dixon Oil Operations, Inc.
Address One Main Place - Suite 606
City/State/Zip Wichita, Kansas 67202
Contact Person Micheal W. Dixon
Phone (316) 264-9632

NE SE NE Sec. 17 Twp. 11 S, Rg. 33 East
3630' Ft. from South Line of Section
330' Ft. from East Line of Section

(Note: Locate well on Section Plat on reverse side)

CONTRACTOR: License # 5104
Name Blue Goose Drilling Co., Inc.
City/State Great Bend, Kansas

Nearest lease or unit boundary line 330' feet
County Logan
Lease Name Vogler Well # 1

Well Drilled For: Well Class: Type Equipment:
X Oil Storage Infield X Mud Rotary
Gas Inj Pool Ext Air Rotary
OWWO Expl Wildcat Cable

Ground surface elevation 3167 feet MSL
Domestic well within 330 feet: yes X no
Municipal well within one mile: yes X no
Depth to bottom of fresh water 230'
Depth to bottom of usable water 1750'

If OWWO: old well info as follows:
Operator
Well Name
Comp Date Old Total Depth

Surface pipe by Alternate 1 2 X
Surface pipe planned to be set 350'
Conductor pipe required None
Projected Total Depth 4800' feet
Formation Mississippian

I certify that well will comply with K.S.A. 55-101, et seq., plus eventually plugging hole to KCC specifications.

Date 7-26-88 Signature of Operator or Agent Micheal W. Dixon Title Vice-President

For KCC Use:
Conductor Pipe Required feet; Minimum Surface Pipe Required 200' feet per Alt. X (2)
This Authorization Expires 1-26-89 Approved By LKM 7-26-88


EFFECTIVE DATE: 7-31-88

Must be filed with the K.C.C. five (5) days prior to commencing well  
This card void if drilling not started within six (6) months of date received by K.C.C.

### Important procedures to follow:

1. Notify District office before setting surface casing.
2. Set surface casing by circulating cement to the top.
3. File completion forms ACO-1 with K.C.C. within 120 days of well spud date, following instructions on ACO-1, side 1, and including copies of wireline logs.
4. Notify District office 48 hours prior to old well workover or re-entry.
5. Prior to filing Intent, prepare a proposed plugging plan in case well is D & A, then obtain approval of plan when calling district office prior to setting surface pipe.
6. Submit plugging report (CP-4) to K.C.C. after plugging is completed.
7. Obtain an approved injection docket number before disposing of salt water.

### A Regular Section of Land 1 Mile = 5,280 Ft.

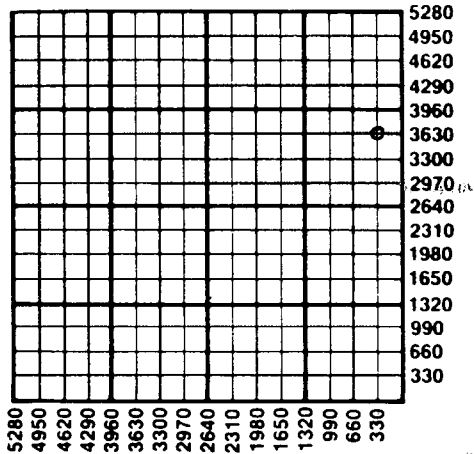

RECEIVED  
STATE CORPORATION COMMISSION  
JUL 26 1988  
3-26-1988  
CONSERVATION DIVISION  
Wichita, Kansas

8. If alternate 2 completion, cement in the production pipe from holdout usable water to surface within 120 days of spud date.

State Corporation Commission of Kansas  
Conservation Division  
200 Colorado Derby Building  
Wichita, Kansas 67202-1212  
(316) 263-3238