

CARD MUST BE TYPED

NOTICE OF INTENTION TO DRILL

CARD MUST BE SIGNED

State of Kansas
(see rules on reverse side)

Starting Date: 12 10 84
month day year

API Number 15- 109-20,365-00-00

OPERATOR: License # 7506

C.N.E. SW. NW. Sec 17. Twp 11. S, Rge 33. East
(location) West

Name First Energy Corporation
Address 16701 Greenspoint Park Dr., St. 200

City/State/Zip Houston, TX 77060

Contact Person Bill Dean

Phone 713-847-5755

CONTRACTOR: License # 6033

Name Murfin Drilling Company

City/State Wichita, KS 67202

3630 Ft North from Southeast Corner of Section
4290 Ft West from Southeast Corner of Section
(Note: Locate well on Section Plat on reverse side)

Nearest lease or unit boundary line 990 feet.

County Logan

Lease Name Vogler Well# 23-17

Domestic well within 330 feet: yes no

Municipal well within one mile: yes no

Well Drilled For: Well Class: Type Equipment:

- Oil Swd Infield Mud Rotary
- Gas Inj Pool Ext. Air Rotary
- OWWO Expl Wildcat Cable

If OWWO: old well info as follows:

Operator

Well Name

Comp Date Old Total Depth

Projected Total Depth 4850 feet

Projected Formation at TD Miss

Expected Producing Formations Miss

Depth to Bottom of fresh water 225 feet

Lowest usable water formation Dakota

Depth to Bottom of usable water 1625 1800 feet

Surface pipe by Alternate: 1 2

Surface pipe to be set 300 feet

Conductor pipe if any required N/A feet

Ground surface elevation --- feet MSL

This Authorization Expires 6-5-85

Approved By 12-584

I certify that we will comply with K.S.A. 55-101, et seq., plus eventually plugging hole to K.C.C. specifications.

Date 12-4-84 Signature of Operator or Agent

Jack E. Goss, Agent for Operator Title Ass't. Drilling Manager


MHC 140116 12/5/84

Must be filed with the K.C.C. five (5) days prior to commencing well completion and void if drilling not started within six (6) months of date received by K.C.C.

RECEIVED
STATE CORPORATION COMMISSION

12-5-1984
DEC 5 1984

A Regular Section of Land
1 Mile = 5,280 Ft.

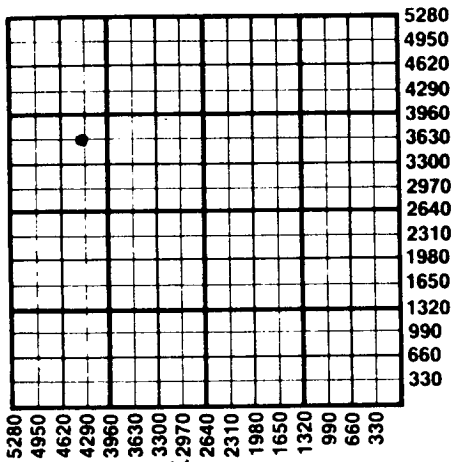

TZ

Important procedures to follow :

1. Notify District office before setting surface casing.
2. Set surface casing by circulating cement to the top.
3. File completion forms ACO-1 with K.C.C. within 90 days of well completion, following instructions on ACO-1, side 1, and including copies of wireline logs.
4. Notify District office 48 hours prior to old well workover or re-entry.
5. Prior to plugging, prepare a plugging plan, then obtain agreement from the appropriate district office for an approved plugging plan.
6. Submit plugging report (CP-4) to K.C.C. after plugging is completed.
7. Obtain an approved injection docket number before disposing of salt water.
8. Notify K.C.C. within 10 days when injection commences or terminates.
9. If an alternate 2 completion, cement in the production pipe from below any usable water to surface within 120 days of spud date.

State Corporation Commission of Kansas
Conservation Division
200 Colorado Derby Building
Wichita, Kansas 67202
(316) 263-3238