

EFFECTIVE DATE: 9-24-91

DISTRICT # 4

SSA? Yes. X No

State of Kansas
NOTICE OF INTENTION TO DRILL

FORM MUST BE TYPED
FORM MUST BE SIGNED
ALL BLANKS MUST BE FILLED

Must be approved by the K.C.C. five (5) days prior to commencing well

Expected Spud Date ..October 1, 1991
month day year

Spot
SE SE SW Sec 22 Twp 11 S Rg 33 East
X West

OPERATOR: License # 4629
Name: Brito Oil Company, Inc.
Address: 200 E. First, Suite 208
City/State/Zip: Wichita, KS 67202
Contact Person: Raul E. Brito
Phone: 316-263-8787

330! feet from South line of Section 2310'
feet from East West line of Section
IS SECTION X REGULAR IRREGULAR?

(NOTE: Locate well on the Section Plat on Reverse Side)
County: Logan
Lease Name: Soucie "B" Well #: 1-22
Field Name: Hubert Extension

CONTRACTOR: License #: 5104
Name: Blue Goose Drilling

Is this a Prorated/Spaced Field? yes X no
Target Formation(s): Lansing, Marm, Chero
Nearest lease or unit boundary: 330'

Well Drilled For: Well Class: Type Equipment:
X Oil ... Enh Rec ... Infield X Mud Rotary
Gas ... Storage X Pool Ext. ... Air Rotary
OWWO ... Disposal ... Wildcat ... Cable
Seismic: # of Holes ... Other

Ground Surface Elevation: NN feet MSL
Water well within one-quarter mile: yes X no
Public water supply well within one mile: yes X no

If OWWO: old well information as follows:
Operator:
Well Name:
Comp. Date: Old Total Depth

Depth to bottom of fresh water: 220'
Depth to bottom of usable water: 1625'
Surface Pipe by Alternate: 1 X 2
Length of Surface Pipe Planned to be set: 200'

Directional, Deviated or Horizontal wellbore? yes X no
If yes, true vertical depth:
Bottom Hole Location:

Length of Conductor pipe required: None
Projected Total Depth: 4700'
Formation at Total Depth: Mississippi
Water Source for Drilling Operations:

... well ... farm pond X other
DWR Permit #:
Will Cores Be Taken? yes X no
If yes, proposed zone:

AFFIDAVIT

The undersigned hereby affirms that the drilling, completion and eventual plugging of this well will comply with K.S.A. 55-101, et. seq.
It is agreed that the following minimum requirements will be met:

- 1. Notify the appropriate district office prior to spudding of well;
- 2. A copy of the approved notice of intent to drill shall be posted on each drilling rig;
- 3. The minimum amount of surface pipe as specified below shall be set by circulating cement to the top; in all cases surface pipe shall be set through all unconsolidated materials plus a minimum of 20 feet into the underlying formation;
- 4. If the well is dry hole, an agreement between the operator and the district office on plug length and placement is necessary prior to plugging;
- 5. The appropriate district office will be notified before well is either plugged or production casing is cemented in;
- 6. IF AN ALTERNATE II COMPLETION, PRODUCTION PIPE SHALL BE CEMENTED FROM BELOW ANY USABLE WATER TO SURFACE WITHIN 120 DAYS OF SPUD DATE. IN ALL CASES, NOTIFY DISTRICT OFFICE PRIOR TO ANY CEMENTING.

I hereby certify that the statements made herein are true and to the best of my knowledge and belief.
Date: 9-18-91 Signature of Operator or Agent: Title: President

RECEIVED
STATE CORPORATION COMMISSION
9-19-1991
SEP 19 1991
Conservation Division
Wichita, Kansas

FOR KCC USE:
API # 15- 109-20,518-00-00
Conductor pipe required None feet
Minimum surface pipe required 200 feet per Alt. ③
Approved by: MPE 9-19-91
This authorization expires: 3-19-92
(This authorization void if drilling not started within 6 months of effective date.)
Spud date: Agent:

REMEMBER TO:

- File Drill Pit Application (form CDP-1) with Intent to Drill;
- File Completion Form ACO-1 within 120 days of spud date;
- File acreage attribution plat according to field proration orders;
- Notify appropriate district office 48 hours prior to workover or re-entry;
- Submit plugging report (GP-4) after plugging is completed;
- Obtain written approval before disposing or injecting salt water.

Mail to: Conservation Division, 200 Colorado Derby Building, 202 W. First St., Wichita, Kansas 67202-1286.

22
11
33W

IN ALL CASES PLOT THE INTENDED WELL ON THE PLAT BELOW

PLAT OF ACREAGE ATTRIBUTABLE TO A WELL IN A PRORATED OR SPACED FIELD

If the intended well is in a prorated or spaced field, please fully complete this side of the form. If the intended well is in a prorated or spaced field complete the plat below showing that the well will be properly located in relationship to other wells producing from the common source of supply. Please show all the wells within 1 mile of the boundaries of the proposed acreage attribution unit for gas wells and within 1/2 mile of the boundaries of the proposed acreage attribution unit for oil wells.

API NO. 15- _____
OPERATOR Brito Oil Company, Inc.
LEASE Soucie "B"
WELL NUMBER. #1-22
FIELD Hubert Extension

LOCATION OF WELL: COUNTY Logan
330' feet from south/~~north~~ line of section
2310' feet from east/~~west~~ line of section
SECTION 22 TWP 11S RG 33W



NUMBER OF ACRES ATTRIBUTABLE TO WELL 10
QTR/QTR/QTR OF ACREAGE SE - SE - SW

IS SECTION X REGULAR or IRREGULAR
IF SECTION IS IRREGULAR, LOCATE WELL FROM NEAREST CORNER BOUNDARY.

Section corner used: NE NW SE SW

PLAT

(Show location of the well and shade attributable acreage for prorated or spaced wells.)
(Show footage to the nearest lease or unit boundary line.)

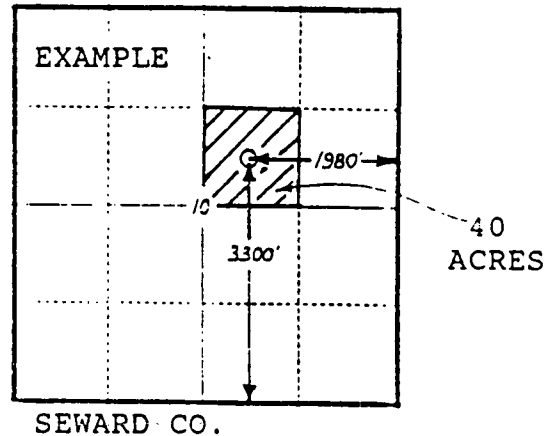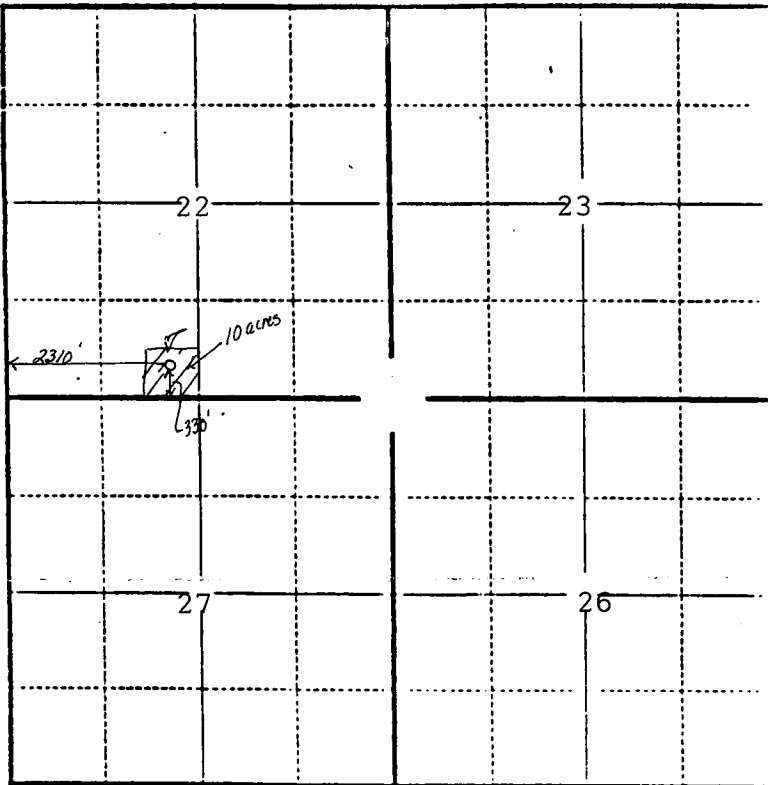

In plotting the proposed location of the well, you must show:

- 1) The manner in which you are using the depicted plat by identifying section lines, i.e. 1 section, 1 section with 8 surrounding sections, 4 sections, etc.;
- 2) the distance of the proposed drilling location from the section's south/north and east/west lines; and
- 3) the distance to the nearest lease or unit boundary line.