


Give All Information Completely  
Make Required Affidavit  
Mail or Deliver Report to:  
Conservation Division  
State Corporation Commission  
P. O. Box 17027  
Wichita, Kansas 67217  
NORTH

WELL PLUGGING RECORD

Logan County. Sec. 23 Twp. 11 Rge. 33W (E) (W)

Location as "NE/CNW/SW" or footage from lines. SW SE SE  
Lease Owner DONALD C. SLAWSON  
Lease Name Bertrand 'MM' Well No. 1  
Office Address 200 Douglas Building Wichita, Kansas 67202  
Character of Well (completed as Oil, Gas or Dry Hole) Dry Hole  
Date well completed August 22, 19 81  
Application for plugging filed August 22, 19 81  
Application for plugging approved August 22, 19 81  
Plugging commenced August 22, 19 81  
Plugging completed August 22, 19 81  
Reason for abandonment of well or producing formation Dry Hole

If a producing well is abandoned, date of last production 19  
Was permission obtained from the Conservation Division or its agents before plugging was commenced? Yes

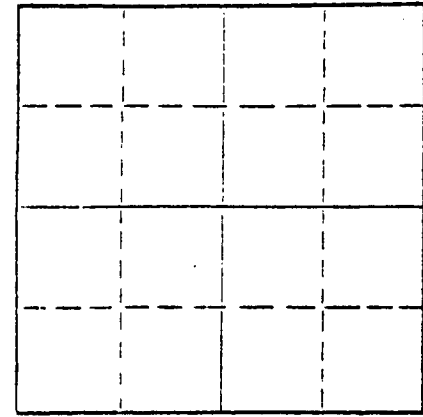

Locate well correctly on above Section Plat

Name of Conservation Agent who supervised plugging of this well Gilbert Balthazor  
Producing formation Depth to top Bottom Total Depth of Well 4760 Feet  
Show depth and thickness of all water, oil and gas formations.

OIL, GAS OR WATER RECORDS

CASING RECORD

FORMATION	CONTENT	FROM	TO	SIZE	PUT IN	PULLED OUT
		surface	329'	8 5/8"		

Describe in detail the manner in which the well was plugged, indicating where the mud fluid was placed and the method or methods used in introducing it into the hole. If cement or other plugs were used, state the character of same and depth placed, from feet to feet for each plug set.

1st plug @ 1500' w/60 sx  
2nd plug @ 300' w/40 sx  
Top plug @ 40' w/10 sx  
5 sx in Rat Hole

RECEIVED  
STATE CORPORATION COMMISSION  
10-13-1981  
OCT 13 1981  
CONSERVATION DIVISION  
Wichita, Kansas

(If additional description is necessary, use BACK of this sheet)  
Name of Plugging Contractor SUN OIL WELL CEMENTING, INC.  
Address Box 169 Great Bend, Kansas 67530


STATE OF KANSAS COUNTY OF SEDGWICK ss.  
William R. Horigan (employee of owner) or (owner or operator) of the above-described well, being first duly sworn on oath, says: That I have knowledge of the facts, statements, and matters herein contained and the log of the above-described well as filed and that the same are true and correct. So help me God.

(Signature) William R. Horigan  
WILLIAM R. HORIGAN  
200 Douglas Building (Address) Wichita, Kansas 67202

SUBSCRIBED AND SWORN TO before me this 7th day of October, 19 81

My commission expires 06/12/82

Sherry L. Kendall  
SHERRY L. KENDALL, Notary Public.

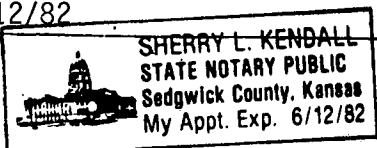

15-109-20178-00-00

WELL LOG

OPERATOR: DONALD C. SLAWSON  
 200 DOUGLAS BUILDING  
 WICHITA, KANSAS 67202

LEASE: #1 Bertrand 'MM'  
 SW SE SE Sec. 23-11-33W  
 Logan County, Kansas

CONTRACTOR: SLAWSON DRILLING COMPANY, INC.  
 200 DOUGLAS BUILDING  
 WICHITA, KANSAS 67202

COMMENCED: August 14, 1981

COMPLETED: August 22, 1981

CASING: Surface - 8 5/8" @ 329' w/275 sx 60/40 poz

0 - 335 Surface  
 335 - 1816 Shale and shells  
 1816 - 2637 Shale  
 2637 - 2667 Anhydrite  
 2667 - 3560 Shale  
 3560 - 4077 Shale and lime  
 4077 - 4760 Lime  
 4760 RTD

RECEIVED  
 STATE CORPORATION COMMISSION  
 10-13-1981  
 OCT 13 1981  
 CONSERVATION DIVISION  
 Wichita, Kansas

STATE OF KANSAS )  
 )  
 COUNTY OF SEDGWICK ) SS.

I, James C. Remsberg, OF THE SLAWSON DRILLING COMPANY, INC.  
 UPON OATH STATE THAT THE ABOVE AND FOREGOING IS A TRUE AND CORRECT COPY OF THE  
 LOG OF THE #1 Bertrand 'MM' TEST.

*James C. Remsberg*  
 JAMES C. REMSBERG, President

SUBSCRIBED AND SWORN TO BEFORE ME THIS 7th DAY OF October, 1981.

*Sherry L. Kendall*  
 SHERRY L. KENDALL, Notary Public

MY COMMISSION EXPIRES: 06/12/82

